



Location Restriction Demonstrations

DTE Electric Company

Monroe Power Plant Inactive Bottom Ash
Impoundment


April 2020

Prepared For:


DTE Electric Company

Prepared By:

TRC
1540 Eisenhower Place
Ann Arbor, Michigan 48108

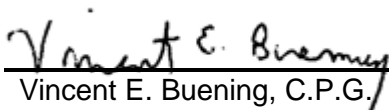

Vincent E. Buening, C.P.G.
Senior Project Geologist

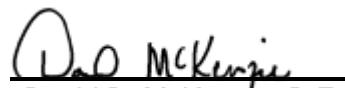

David B. McKenzie, P.E.
Senior Project Engineer

TABLE OF CONTENTS

Certification	ii
1.0 Background	1
1.1 Facility and CCR Unit Information.....	1
1.2 Site Setting.....	1
2.0 Location Restrictions	3
2.1 §257.60 – Placement Above the Uppermost Aquifer.....	3
2.2 §257.61 – Wetlands	3
2.3 §257.62 – Fault Areas	4
2.4 §257.63 – Seismic Impact Zone.....	4
2.5 §257.64 – Unstable Areas.....	5
3.0 Conclusions	6
4.0 References	7


APPENDICES

Appendix A	Monitoring Well Boring Logs
Appendix B	Cross Sections
Appendix C	National Wetland Inventory Map
Appendix D	U.S. Quaternary Faults and Folds Map
Appendix E	Seismic Design Curves

Certification

I, the undersigned Michigan Professional Engineer, hereby certify that I am familiar with the technical requirements of Title 40 Code of Federal Regulations Part 257 Subpart D (§257). I also certify that it is my professional opinion that, to the best of my knowledge, information, and belief, that the information in this demonstration is in accordance with current good and accepted engineering practice(s) and standard(s) and meets the requirements of §257.60 through §257.64.

For the purpose of this document, "certify" and "certification" shall be interpreted and construed to be a "statement of professional opinion." The certification is understood and intended to be an expression of my professional opinion as a Michigan Licensed Professional Engineer, based upon knowledge, information, and belief. The statement(s) of professional opinion are not and shall not be interpreted or construed to be a guarantee or a warranty of the analysis herein.

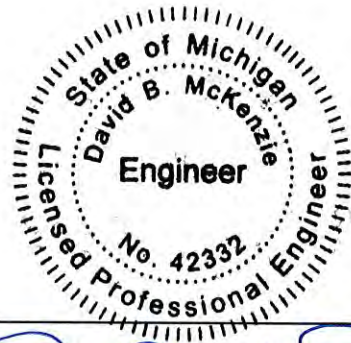

Seal/Date

Name

License No:



4/14/2020

6201042332

Expires: October 31, 2021

1.0 Background

The purpose of this document is to determine whether the inactive Coal Combustion Residual (CCR) inactive Bottom Ash Impoundment (BAI) at the Monroe Power Plant (MONPP) is in compliance with the location restrictions outlined in the Environmental Protection Agency's (EPA) final CCR rule [Title 40 Code of Federal Regulations Parts 257 and 261] Subpart D – “Standards for the Disposal of Coal Combustion Residuals in Landfills and Surface Impoundments” (§257.60 through §257.64, federal rule). The BAI is an inactive CCR surface impoundment.

This document includes information from a desktop study, well installation activities, and engineering calculations to demonstrate whether or not the inactive BAI is in compliance with location restrictions (§257.60 through §257.64).

Supporting documents are provided as appendices to this demonstration.

1.1 Facility and CCR Unit Information

The MONPP is located in Section 16, Township 7 South, Range 9 East, at 3500 Front Street, Monroe in Monroe County, Michigan. The inactive BAI was operated from the mid-1970s through 2015 and is located within the southern portion of the MONPP parcel at latitude 41° 52' 30" North and longitude 83° 20' 70" West. The MONPP inactive BAI is bounded by the MONPP facility to the north and northeast, Lake Erie to the southeast, process water pond to the south, and discharge canal to the west. DTE Electric is currently planning to close the MONPP inactive BAI by removing all CCR material from the basin. The design for the closure by removal is ongoing.

1.2 Site Setting

The MONPP inactive BAI CCR unit is located immediately east of the discharge canal and immediately north and east of Lake Erie. The bedrock in the site vicinity is overlain by approximately 40 to 50 feet of unconsolidated deposits of glacial origin. The deposits are comprised of two (2) distinct units: a hard glacial till immediately overlying bedrock, and lacustrine (lake bed or lake shore) deposits which overlay the till unit. The till is comprised of over consolidated (highly compacted) gray silty to sandy clay with some cobbles and boulders, and ranges from approximately 20 to 50 feet in thickness. The overlying lacustrine deposits are composed of 10 to 30 feet of fine-grained sand and silt with some soft clay except where there is a thin, discontinuous coarse sand unit at the base of the lacustrine sequence. The uppermost aquifer at the MONPP inactive BAI consists of this fine-grained sand unit and is located at a depth of 18 to 37 ft below ground surface.

A groundwater monitoring system has been established for the MONPP inactive BAI CCR unit as detailed in the Monitoring Well Installation Report – Inactive Bottom Ash Basin, DTE Monroe Plant (Well Installation Report) (AECOM, April 2019). The detection monitoring well network for the MONPP inactive BAI CCR unit currently consists of twelve monitoring wells that are screened in the uppermost aquifer. The monitoring well boring logs are included in Appendix A.

Under parts of the Plant, the Inactive BAI, and Process Pond areas, this sand unit ranges in thickness from 5 to 20 feet. The sand unit thins progressively to the west, having a thickness of approximately 12 feet on the east side of the discharge canal and thinning to less than a few feet approximately 150 feet to the west of the discharge canal. Further to the west the sand unit is

not evident in soil borings for monitoring wells drilled in 2016 around the Fly Ash Basin. This is consistent with the expectation that lake-deposited materials will decrease in thickness with distance away from Lake Erie. Accordingly, it appears that this sand unit is a localized lakeshore beach deposit formed by westward aggradation with rising lake level and subsequently blanketed by finer lacustrine deposits. Groundwater in the sand unit is under semi-confined conditions with groundwater elevations ranging between approximately 572.6 and 575.6 feet above mean sea level (msl).

A mean hydraulic conductivity of approximately 125 feet/day was averaged from the hydraulic conductivity values calculated for MW-1S, MW-3S, MW-7S, and MW-8S during aquifer testing as described in the Well Installation Report. Potentiometric groundwater elevation data collected from 2017 through 2019 shows that horizontal groundwater flow within the upper aquifer unit is generally to the south and southeast toward Lake Erie. The hydraulic gradient toward the southeast in May 2019 was 0.0017 foot/foot.

2.0 Location Restrictions

The assessments for location restrictions designated in the federal CCR rule are presented below. The location restrictions include placement above the uppermost aquifer, within wetlands, near fault areas, within seismic impact zones, and unstable areas based on available geologic and geomorphological information. Supporting information for the demonstrations is included in the appendices to this report.

2.1 §257.60 – Placement Above the Uppermost Aquifer

The federal CCR rule requires that CCR units such as the MONPP inactive BAI must be constructed with a base that is located no less than 1.52 meters (five feet) above the upper limit of the uppermost aquifer or must demonstrate that there will not be an intermittent, recurring, or sustained hydraulic connection between any portion of the base of the CCR unit and the uppermost aquifer due to normal fluctuations in the groundwater elevations (including the seasonal high water table). As discussed in Section 1.2 and shown on the cross-sections included in Appendix A, the uppermost aquifer at the inactive BAI is the fine-grained sand unit. Soil borings completed at the inactive BAI indicate that the ash in some locations, for example at boring 741, extends down to within 5 feet of the uppermost aquifer.

Based on this demonstration, the base of the MONPP inactive BAI CCR unit is not uniformly located greater than 5 feet above the upper limit of the uppermost aquifer. Therefore, the MONPP inactive BAI CCR unit is not in compliance with the requirements of §257.60 and is subject to closure requirements under 40 CFR 257.101(b)(1).

2.2 §257.61 – Wetlands

The CCR location standards restrict existing and new CCR surface impoundments from being located in wetlands, as defined at 40 CFR 232.2 (40 CFR 257.61(a)). Wetlands are defined in 40 CFR 232.2 *Waters of the United States (3)(iv)* as, "...those areas that are inundated or saturated by surface or groundwater at a frequency and duration sufficient to support, and that under normal circumstances do support, a prevalence of vegetation typically adapted for life in saturated soil conditions. Wetlands generally include swamps, marshes, bogs, and similar areas." TRC reviewed National Wetland Inventory (NWI) maps and Michigan Resource Information System (MIRIS) Land Cover Maps archived and available through Michigan Department of Natural Resources (MDNR), Michigan Resource Inventory Program (MRIP) to ascertain whether or not the MONPP inactive BAI is located in wetlands.

As shown on the NWI map in Appendix C, soils at and in the vicinity of the site are designated as wetland soils, most likely due to the proximity of the site to Plum Creek and Lake Erie. The inactive MONPP BAI CCR unit is identified as wetlands on NWI and MIRIS maps. In addition, the NWI (2005) recognizes areas within the BAI as wetlands. However, per the Natural Resources and Environmental Protection Act (NREPA), PA 451 of 1994, Section 324.30305(4)(b), a wetland incidentally created as a result of construction and operation of a water treatment pond, lagoon, or storm water facility in compliance with the requirements of state or federal water pollution control laws is not subject to regulation. The inactive BAI was constructed as a settling pond for the National Pollutant Discharge Elimination System (NPDES) permit. As such, the inactive BAI is a water treatment pond exempt from Michigan wetland regulations and would not be considered a wetland.

Based on TRC's review of wetland inventory resources and current site conditions, the MONPP inactive BAI CCR unit is not located within wetlands as defined in 40 CFR 232.2 and as such, is in compliance with the requirements of §257.61.

2.3 §257.62 – Fault Areas

The federal CCR rule requires that CCR units not be located within 60 meters (200 feet) of the outermost damage zone of a fault that has had displacement in Holocene time (within the most recent 11,700 years) unless the owner or operator demonstrates that an alternative setback distance of less than 60 meters (200 feet) will not cause damage to the structural integrity of the CCR unit. United States Geologic Survey (USGS)-recognized Quaternary faults in the U.S. are shown on the map in Appendix D.

The lower peninsula of Michigan is covered by a mantle of glacial deposits obscuring any surficial evidence of faulting (Bricker, 1977). In these areas of glacial deposition, fault zones are considered to be stable, and any recent recorded earth movement in Michigan has been noted to originate from source depths of 95 to 110 kilometers into the subsurface (Brinker, 1977). Historical records indicate that nearly all seismic events that have occurred in Michigan have been relatively minor in intensity (I to VI on the Modified Mercalli Intensity Scale).

There is no evidence of active faulting during the Holocene in the MONPP inactive BAI CCR unit; therefore, the MONPP inactive BAI CCR unit is in compliance with the requirements of §257.62.

2.4 §257.63 – Seismic Impact Zone

The federal CCR rule requires that CCR units not be located in seismic impact zones unless the owner or operator demonstrates that all structural components including liners, leachate collection and removal systems, and surface water control systems, are designed to resist the maximum horizontal acceleration in lithified earth material for the site. The federal CCR rule defines a seismic impact zone as “an area having a 2% or greater probability that the maximum expected horizontal acceleration, expressed as a percentage of the earth's gravitation pull (g), will exceed 0.10 g in 50 years.”

To determine whether the MONPP inactive BAI CCR unit is located in a seismic impact zone, the USGS National Seismic Hazard Mapping Project (NSHMP) Unified Hazards Tool was consulted to determine the earthquake hazard for the inactive BAI. The Unified Hazard Tool utilizes USGS hazard models to evaluate the hazard curves and hazard response spectrums for a location.

Using the updated Conterminous U.S. 2014 dynamic mode (v4.2.0), the Unified Hazard Tool indicates a mapped peak ground acceleration (PGA) of 0.0624 g for the MONPP inactive BAI CCR unit area (Appendix E). This calculated PGA is less than 0.10 g in 50 years.

There is no evidence of a seismic impact zone in this determination; therefore, TRC concludes that the MONPP inactive BAI CCR unit is not located in a seismic impact zone. Therefore, MONPP inactive BAI CCR unit is in compliance with the requirements of §257.63.

2.5 §257.64 – Unstable Areas

The federal CCR rule requires that CCR units not be located in an unstable area unless the owner or operator demonstrates that recognized and generally accepted good engineering practices have been incorporated into the design of the CCR unit to ensure that the integrity of the structural components of the CCR unit will not be disrupted. Factors associated with soil conditions resulting in significant differential settlement, geologic or geomorphologic features, and human-made features or events must be evaluated to determine compliance.

This demonstration was performed by reviewing local geology and topography and evaluating the results of the Structural Stability Assessment (AECOM, 2019) and Safety Factor Assessment (AECOM, 2019).

Soil borings and monitoring well installations at the MONPP inactive BAI identified overlying lacustrine deposits consisting of fine-grained sand and silt with some soft clay. Below the lacustrine deposits is glacial till consisting of overconsolidated silty to sandy clay. The clay and silt exhibit a very stiff to hard consistency, with harder soils noted with depth. The glacial till occurs above weathered and competent limestone bedrock. Based on these geotechnical records, there is no evidence of unstable soil or underlying bedrock conditions proximal to the MONPP inactive BAI CCR unit.

Based on information maintained by the Michigan Natural Features Inventory and Michigan State University Extension, Monroe County topography, due to the presence of underlying limestone bedrock, is subject to the potential but infrequent occurrence of sinkholes and caves. However, no evidence of sinkholes or caves have been discovered or noted at the MONPP property and therefore are not expected to contribute to the development of unstable site soil conditions.

In 2019, AECOM performed a slope stability safety factor assessment and an overall structural stability assessment for the MONPP inactive BAI CCR unit. The slope stability assessment for the inactive BAI berms concluded that the inactive BAI meets the safety factor requirements under both steady state (normal) and maximum surcharge conditions. The structural stability assessment further concluded that the inactive BAI meets all structural stability criteria under the CCR Rule.

In this determination, there is no evidence of unstable areas due to:

- soil conditions resulting in significant differential settling,
- geologic or geomorphologic features, or
- human-made features or events

Therefore, it is TRC's opinion that MONPP inactive BAI CCR unit is not located in an unstable geological area and that the inactive BAI berm meets safety factor requirements at current operating conditions and berm structural conditions. Therefore, the MONPP inactive BAI CCR unit, is in compliance with the requirements of §257.64.

3.0 Conclusions

Based on the evaluation provided in this documentation, the MONPP inactive BAI CCR unit is not in compliance with the location restrictions provided in §257.60 of the CCR rule. Accordingly, the MONPP inactive BAI must cease receipt of CCR and non-CCR waste streams. The MONPP inactive BAI CCR unit ceased placement of CCR in 2015 and is currently being prepared to undergo closure by removal of CCR. Therefore, no further action is required after this demonstration has been placed into the operating record, posted to the publicly-accessible website, and government notifications provided.

4.0 References

- AECOM. March 2018, revised August 2019. Safety Factor Assessment Report - Inactive Bottom Ash Impoundment DTE Monroe Power Plant.
- AECOM. April 2019, revised August 2019. Monitoring Well Installation Report Coal Combustion Residuals (CCR) Rule - Inactive Bottom Ash Impoundment DTE Monroe Power Plant, Monroe, Michigan.
- AECOM. August 2019. CCR Certification: Structural Stability Assessment - Inactive Bottom Ash Impoundment DTE Monroe Power Plant.
- Bricker, D. Michael. 1977. Circular 14—Seismic Disturbances in Michigan. https://www.michigan.gov/documents/deq/GIMDL-CR14_216127_7.PDF. Lansing, MI.
- Nicholson, S.W., Dicken, C.L., Foose, M.P., and J. Mueller. 2004. Integrated geologic map databases for the United States, the upper midwest states: Minnesota, Wisconsin, Michigan, Illinois, and Indiana. U.S. Geologic Service. Available online at <https://mrdata.usgs.gov/geology/state/map-us.html#home>. Accessed [3/12/2020].
- TRC. July 2019. Annual Groundwater Monitoring Report – DTE Electric Company Monroe Power Plant Bottom Ash Basin Inactive Coal Combustion Residual Unit.
- United States Fish and Wildlife Service. 2010. “Wetlands Mapper.” National Wetlands Inventory. Available online at <http://geohazards.usgs.gov/deaggint/2008/>. Accessed [3/9/2020].
- United States Geological Survey (USGS). 2019. Unified Hazard Tool. Available Online at <https://earthquake.usgs.gov/hazards/interactive/>. Accessed [3/12/2020].
- USGS. U.S. Quaternary Faults and Fold Database. USGS Geologic Hazards Science Center, Golden, CO Available online at <https://usgs.maps.arcgis.com/apps/webappviewer/index.html?id=db287853794f4555b8e93e42290e9716>. Accessed [9/7/2018].

Appendix A

Monitoring Well Boring Logs

DTE Monroe Plant
 Area 15 Monitoring Well and Soil Boring Summary
 Monroe, Michigan

Well ID	Well Elevation ft BTOC	Ground Surface Elevation feet	Northing (ft)	Easting (ft)	Total Boring Depth ft bgs	Well Screen Interval (feet bgs)		Well Type	Location
						Top	Bottom		
MW-1D	582.82	579.4	140178.92	13401952.04	80	70	80	Bedrock	Area 15 East
MW-1S	582.62	579.8	140176.14	13401951.05	41	31	41	Unconsolidated	Area 15 East
MW-2S	578.85	579.2	139070.06	13401077.48	50	31	41	Unconsolidated	Area 15 Southeast
MW-3D	577.42	578.0	139422.09	13399871.16	80	69	79	Bedrock	Area 15 Southwest
MW-3S	577.58	578.1	139417.18	13399871.43	40	30	40	Unconsolidated	Area 15 Southwest
MW-4S	580.67	578.1	141163.06	13401614.14	40	27	37	Unconsolidated	Area 15 Northeast
MW-5S	584.50	581.7	142564.92	13401176.41	70	13	23	Unconsolidated	Area 15 North
MW-7D	576.17	576.7	141099.21	13399510.92	70	59	69	Bedrock	Area 15 West
MW-7S	576.20	576.6	141102.76	13399510.36	34	24	34	Unconsolidated	Area 15 West
MW-8D	586.45	583.7	140561.00	13397828.00	70	56.5	66.5	Bedrock	Fly Ash Basin (west of discharge canal)
MW-8S	586.59	583.7	140560.53	13397828.28	43	33	43	Unconsolidated	Fly Ash Basin (west of discharge canal)
SB-5*	NS	NS	142313.54	13400621.21	70	NA	NA	NA	Area 15 North/Northwest (soil boring only)
SB-6*	NS	NS	139982.04	13400703.89	80	NA	NA	NA	Area 15 - Middle of Separation Berm (soil boring only)

NS - Not Surveyed

NA - Not Applicable

Monitoring Well Coordinate System:NAD83_2011+NAVD88

*Soil Boring Coordinate Source: GIS Software data points converted using: <https://beta.ngs.noaa.gov/gtkweb/>

MON-PP-0068-16

Discharge Canal

Conveyance Lines to Fly Ash Basin

MW-8S/8D

Separation Berm

MW-7S/7D

MW-3S/3D

SB-5

SB-6

MW-5S

MW-4S




MW-1S/1D


MW-2


Lake Erie


Aerial Source: Esri, DigitalGlobe, GeoEye, Earthstar Geographics, CNES/Airbus DS, USDA, USGS, AEX, Getmapping, Aerogrid, IGN, IGP, swisstopo, and the GIS User Community and Google Earth 2016 Aerial Imagery

Document Path: J:\Project\GIS\ID\IDT\Monroe Plant\DT\Monroe_ML_Well Location Map_072516.mxd

- LEGEND:**
-  Proposed Investigation Location - Bottom-Ash Basin Area
 -  Proposed Investigation Location - Fly-Ash Basin Area
 -  Soil Boring

 Unit Separation Berm

 Approximate Plant Boundary

 Approximate Boundary of Inactive Bottom Ash Basin

0 720 1,440 Feet



Monroe Power Plant

**FIGURE 2
PROPOSED
GROUNDWATER INVESTIGATION
LOCATIONS MAP**

DATE: 10/17/2016

SCALE 1 inch = 720 feet

CREATED BY: KLP

JOB NO. 60489524


Project: DTE Monroe Plant
Project Location: Monroe, Michigan
Project Number: 60489524

**Log of
 MW-1D**

Sheet 1 of 3

**MON
 856**

Date(s) Drilled	9/15/16 to 9/19/2016	Logged By	Ron Friend	Checked By	M Hawrylak
Drilling Method	Sonic	Drill Bit Size/Type	Sonic 6"	Total Depth of Borehole	80.0 ft
Drill Rig Type	Mini Sonic	Drilling Contractor	Cascade Drilling	Surface Elevation	579.4 ft msl
Borehole Backfill	Monitoring Well	Sampling Method(s)	Sonic Core Barrel - 4"	Top of Casing Elevation	582.82 ft msl
Boring Location	Inactive Bottom Ash Basin	Groundwater Level(s)	Artesian (flowing) [Measurement after development]		

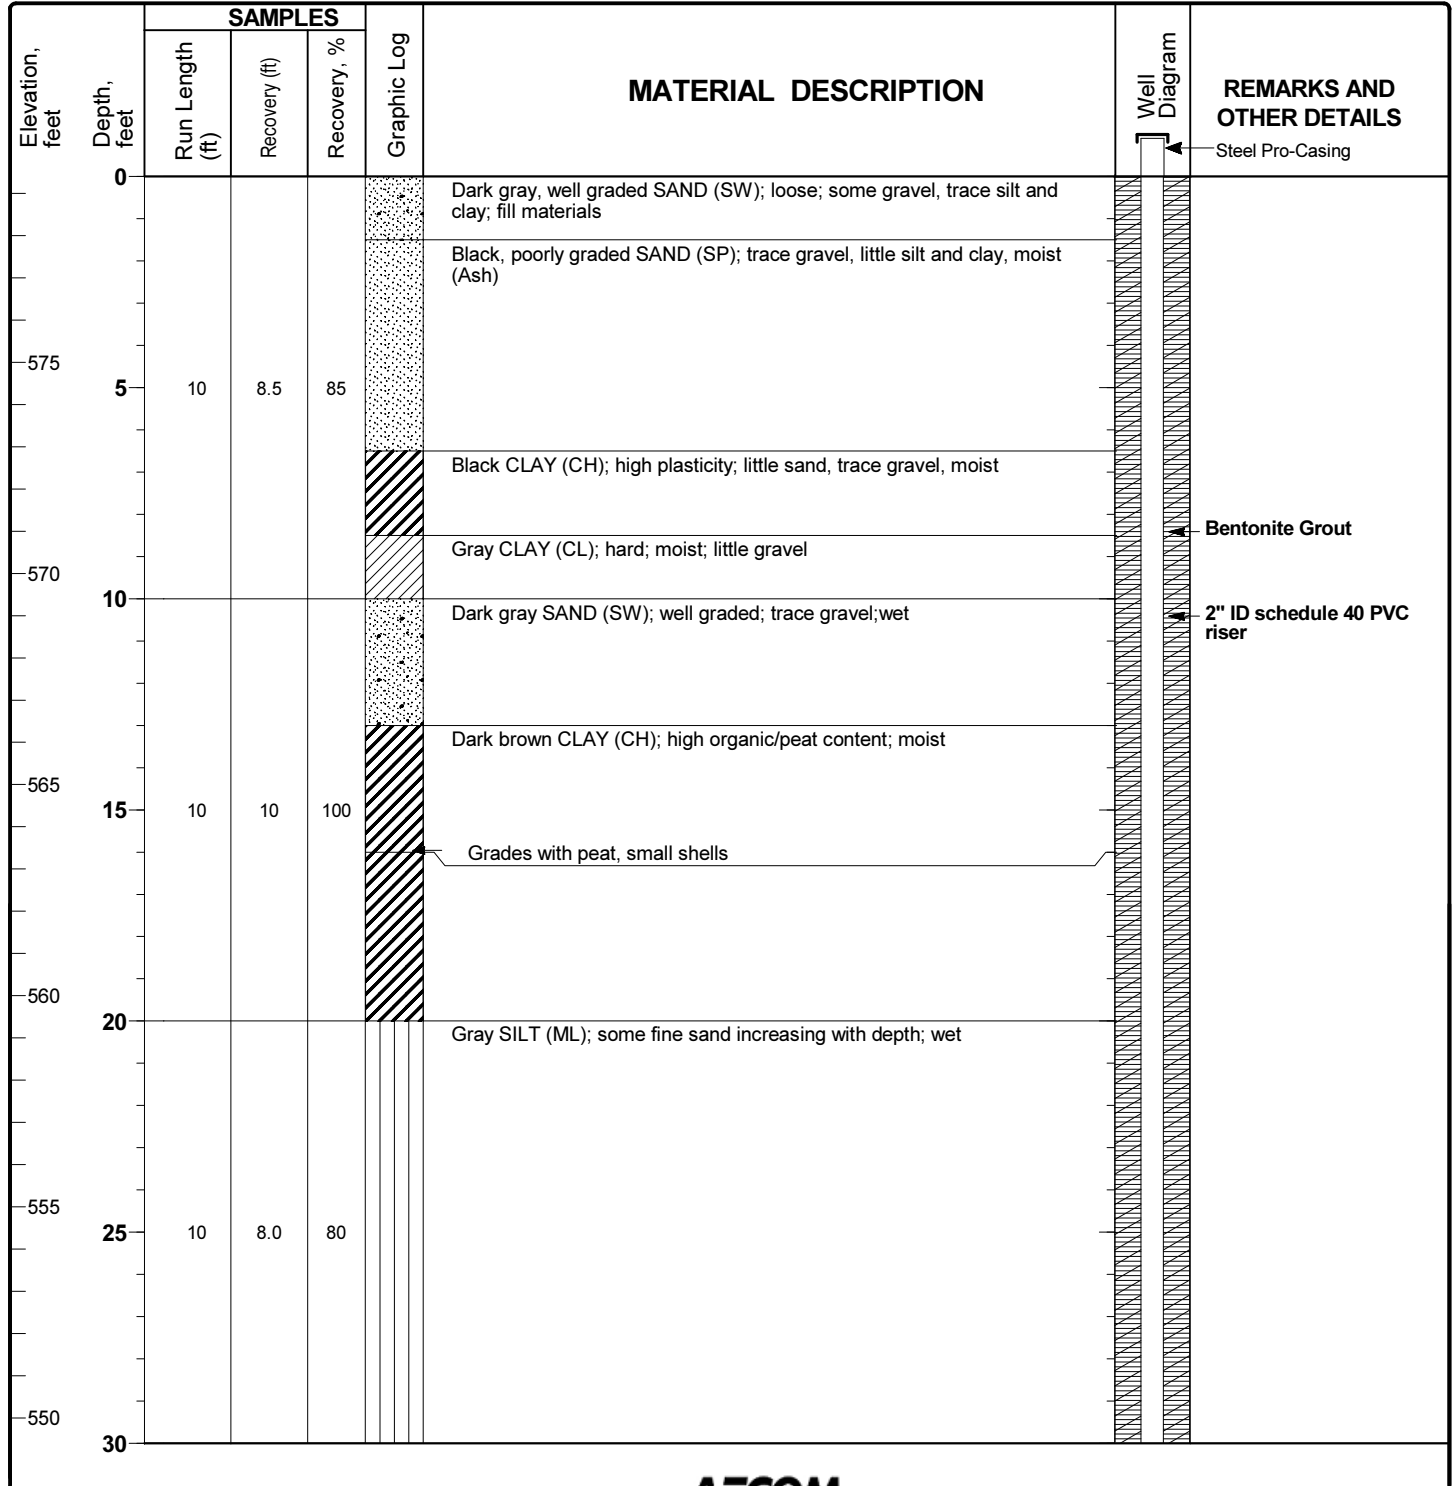

Report: DTE_MONROE; File J:\RESOURCE\DISCIPLINES\ENV\GINT\PROJECTS\IDTE\MONROE_GRANVILLE_CLONE.GPJ; 3/24/2017 3:24:41 PM

Project: DTE Monroe Plant
Project Location: Monroe, Michigan
Project Number: 60489524

Log of MW-1D
 Sheet 2 of 3

MON 856




Elevation, feet	Depth, feet	SAMPLES			Graphic Log	MATERIAL DESCRIPTION	REMARKS AND OTHER DETAILS
		Run Length (ft)	Recovery (ft)	Recovery, %			
30							
545	35	10	8.5	85	Dark gray fine SAND (SP-SM); poorly graded; some silt; wet		
540	40				same as above; decayed wood present Gray GRAVEL (GW); rounded; well graded; trace clay; wet	Bentonite Grout 2" ID schedule 40 PVC riser	
535	45	10	10	100	Gray CLAY (CL); glacial till; hard; trace fine sand; moist		
530	50						
525	55	5	5.0	100	Highly weathered LIMESTONE-SHALE (large bedrock inclusion in till)		
520	60	5	5.0	100	Gray CLAY (CL); glacial till; very hard; trace medium sand; dry		
515	65	5	0.5	10			

Report: DTE_MONROE; File J:\RESOURCE\DISCIPLINES\ENV\GINT\PROJECTS\DTE\MONROE_GRANVILLE CLONE.GPJ; 3/24/2017 3:24:41 PM

Project: DTE Monroe Plant
Project Location: Monroe, Michigan
Project Number: 60489524

Log of MW-1D
 Sheet 3 of 3

MON
856

Elevation, feet	Depth, feet	SAMPLES			Graphic Log	MATERIAL DESCRIPTION	REMARKS AND OTHER DETAILS
		Run Length (ft)	Recovery (ft)	Recovery, %			
510	70	5	2.75	55		Bentonite Grout 2" ID schedule 40 PVC riser Bentonite Seal SCH 40 PVC 2" Diameter 0.01" Slotted Screen	
505	75	5	4.0	80		LIMESTONE-SHALE (bedrock); gray, highly weathered; wet; some intact 2"-3"	
500	80	5	5.0	100		LIMESTONE (bedrock); gray, slightly weathered; breaks apart with hammer blows; moist to wet	
495	85					End of boring	
490	90						
485	95						
480	100						

Report: DTE_MONROE; File J:\RESOURCE\DISCIPLINES\ENV\GINT\PROJECTS\IDTE\MONROE_GRANVILLE_CLONE.GPJ; 3/24/2017 3:24:41 PM


Project: DTE Monroe Plant
Project Location: Monroe, Michigan
Project Number: 60489524

**Log of
 MW-1S**

Sheet 1 of 2

**MON
 857**

Date(s) Drilled	9/15/16 to 9/19/2016	Logged By	Ron Friend	Checked By	M Hawrylak
Drilling Method	Sonic	Drill Bit Size/Type	Sonic 6"	Total Depth of Borehole	41.0 ft
Drill Rig Type	Mini Sonic	Drilling Contractor	Cascade Drilling	Surface Elevation	579.8 ft msl
Borehole Backfill	Monitoring Well	Sampling Method(s)	Sonic Core Barrel - 4"	Top of Casing Elevation	582.62 ft msl
Boring Location	Inactive Bottom Ash Basin	Groundwater Level(s)	9.42' BTOC [Measurement after development]		

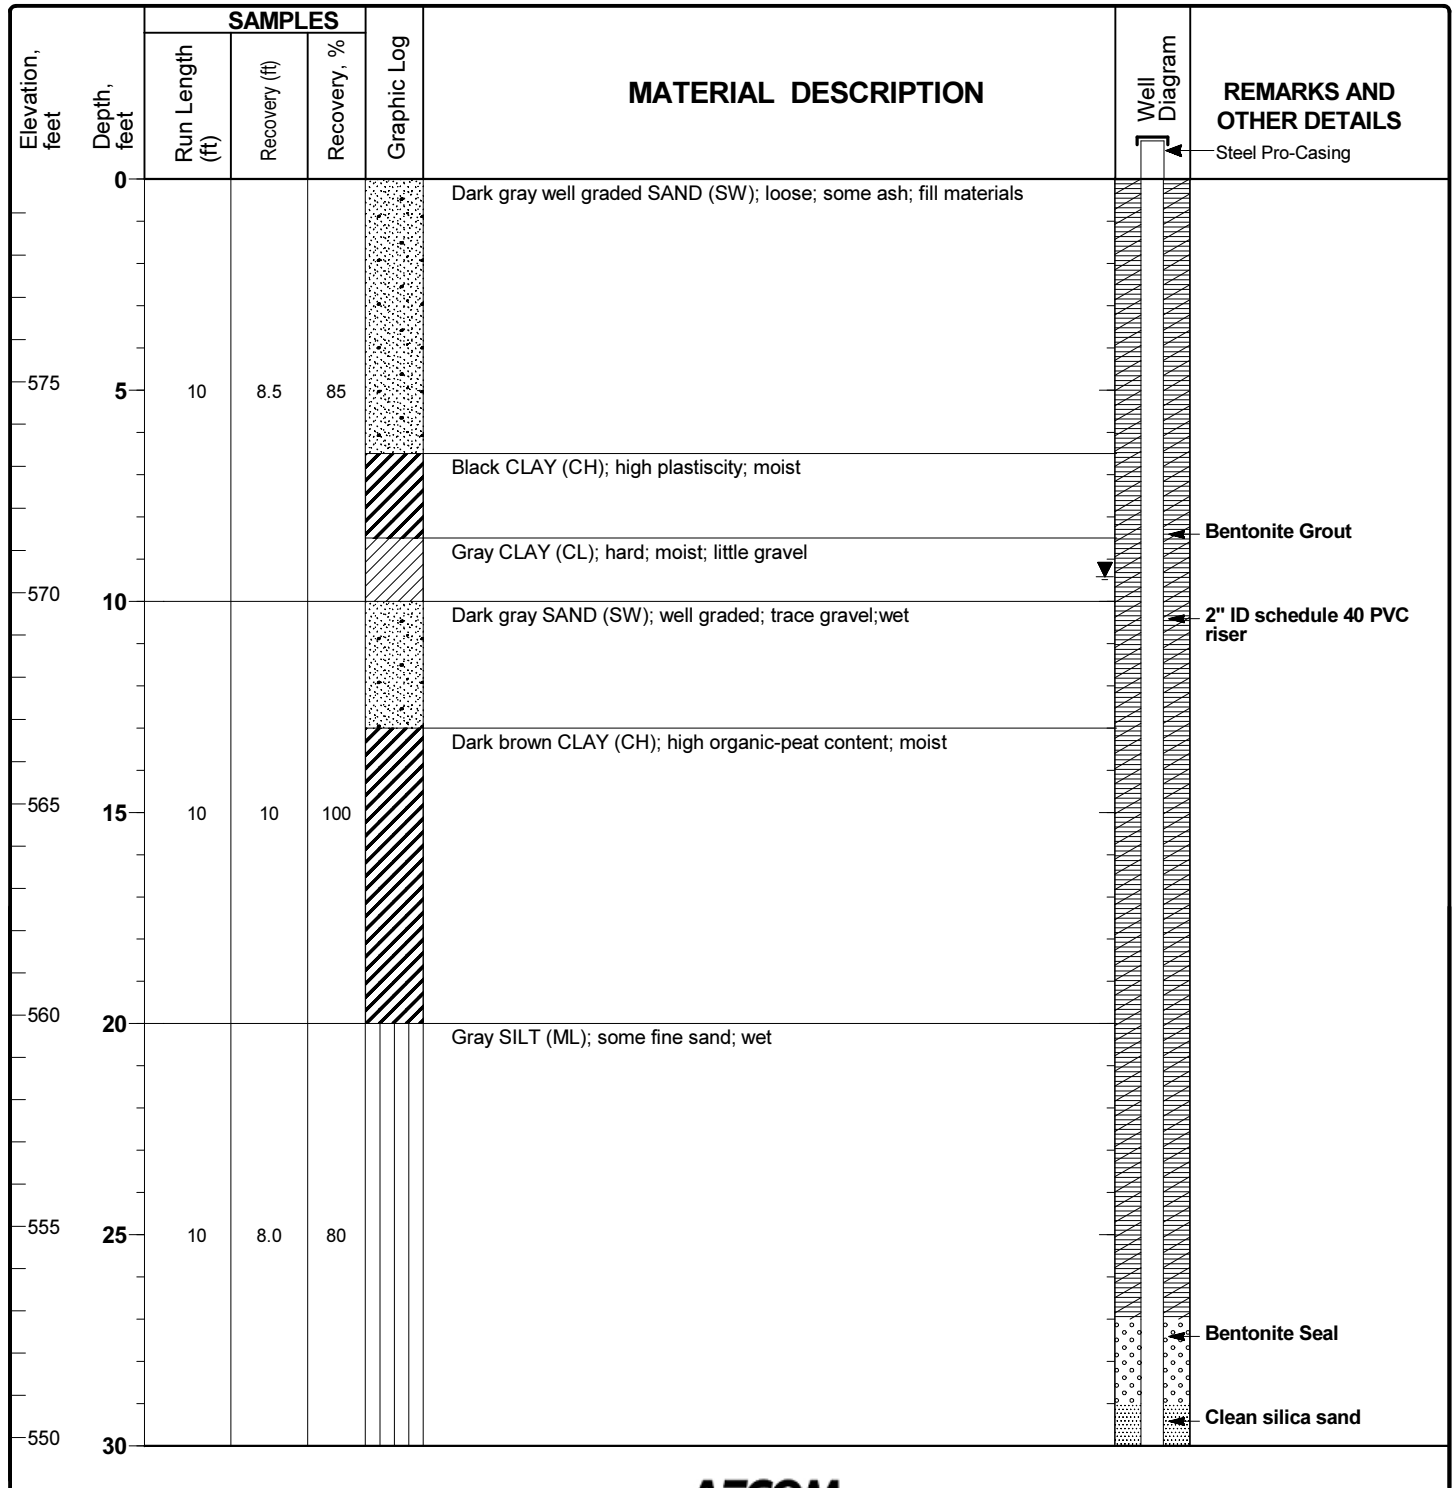



Report: DTE_MONROE; File J:\RESOURCE\DISCIPLINES\ENV\GINT\PROJECTS\IDTE\MONROE_GRANVILLE_CLONE.GPJ; 3/24/2017 3:24:47 PM

Project: DTE Monroe Plant
Project Location: Monroe, Michigan
Project Number: 60489524

Log of MW-1S
 Sheet 2 of 2


MON 857

Elevation, feet	Depth, feet	SAMPLES			Graphic Log	MATERIAL DESCRIPTION		REMARKS AND OTHER DETAILS
		Run Length (ft)	Recovery (ft)	Recovery, %				
30							2" ID schedule 40 PVC riser	
							SCH 40 PVC 2" Diameter 0.01" Slotted Screen	
545	35	10	8.5	85		Dark gray fine SAND (SP-SM); poorly graded; some silt; wet	Clean silica sand	
540	40					same as above; decayed wood present Gray GRAVEL (GW); rounded; well graded; trace clay; wet		
535	45	10	10	100			End of boring	
530	50							
525	55							
520	60							
515	65							

Report: DTE_MONROE; File J:\RESOURCE\DISCIPLINES\ENV\GINT\PROJECTS\IDTE\MONROE_GRANVILLE_CLONE.GPJ; 3/24/2017 3:24:48 PM

Project: DTE Monroe Plant	Log of MW-2S Sheet 1 of 2	MON 858
Project Location: Monroe, Michigan		
Project Number: 60489524		

Date(s) Drilled: 9/19/16 to 9/19/2016	Logged By: Ron Friend	Checked By: M Hawrylak
Drilling Method: Sonic	Drill Bit Size/Type: Sonic 6"	Total Depth of Borehole: 50.0 ft
Drill Rig Type: Mini Sonic	Drilling Contractor: Cascade Drilling	Surface Elevation: 579.2 ft msl
Borehole Backfill: Monitoring Well	Sampling Method(s): Sonic Core Barrel - 4"	Top of Casing Elevation: 578.85 ft msl
Boring Location: Inactive Bottom Ash Basin	Groundwater Level(s): 4.91' BTOC [Measurement after development]	

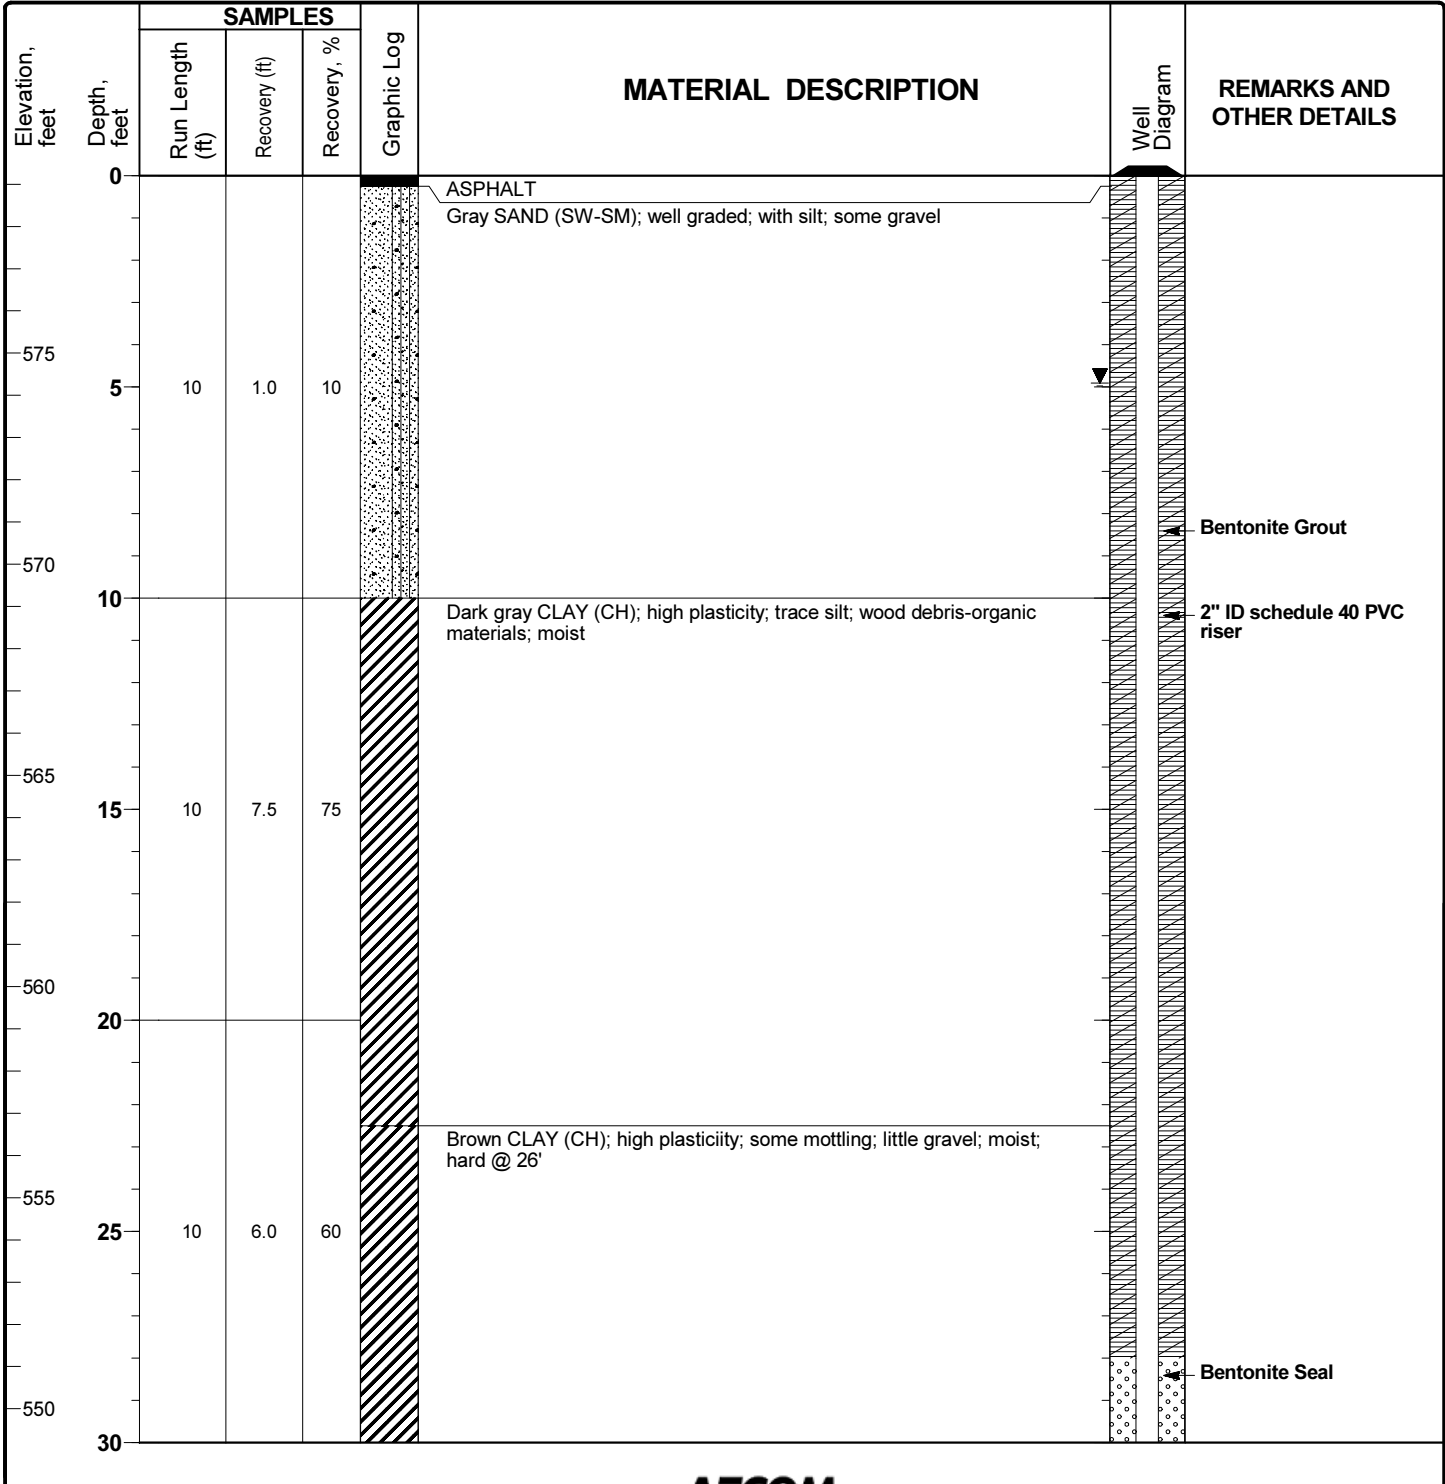

Report: DTE_MONROE; File J:\RESOURCE\DISCIPLINES\ENV\GINT\PROJECTS\IDTE\MONROE_GRANVILLE CLONE.GPJ; 3/24/2017 3:24:56 PM

Project: DTE Monroe Plant
Project Location: Monroe, Michigan
Project Number: 60489524

Log of MW-2S
 Sheet 2 of 2

MON 858

Elevation, feet	Depth, feet	SAMPLES			Graphic Log	MATERIAL DESCRIPTION	REMARKS AND OTHER DETAILS
		Run Length (ft)	Recovery (ft)	Recovery, %			
30						2" ID schedule 40 PVC riser	
					Dark gray CLAY (CL); trace coarse sand; little gravel; very hard; dry-moist	SCH 40 PVC 2" Diameter 0.01" Slotted Screen	
545	35	10	8.5	85		Clean silica sand	
					Dark gray SAND (SP-SM); poorly graded; fine grained; some silt; wet		
540	40						
					Dark gray SAND (SP); poorly graded; wet		
					Dark Gray CLAY (CL); glacial till; very hard, trace gravel and sand; moist	Bentonite Seal	
535	45	10	8.0	80			
530	50					End of boring	
525	55						
520	60						
515	65						

Report: DTE_MONROE; File J:\RESOURCE\DISCIPLINES\GINT\PROJECTS\DTE\MONROE_GRANVILLE_CLONE.GPJ; 3/24/2017 3:24:57 PM


Project: DTE Monroe Plant
Project Location: Monroe, Michigan
Project Number: 60489524

Log of MW-3D

Sheet 1 of 3

MON
859

Date(s) Drilled	9/20/16 to 9/20/2016	Logged By	Ron Friend	Checked By	M Hawrylak
Drilling Method	Sonic	Drill Bit Size/Type	Sonic 6"	Total Depth of Borehole	80.0 ft
Drill Rig Type	Mini Sonic	Drilling Contractor	Cascade Drilling	Surface Elevation	578.0 ft msl
Borehole Backfill	Monitoring Well	Sampling Method(s)	Sonic Core Barrel - 4"	Top of Casing Elevation	577.42 ft msl
Boring Location	Inactive Bottom Ash Basin	Groundwater Level(s)	Artesian (flowing) [Measurement after development]		

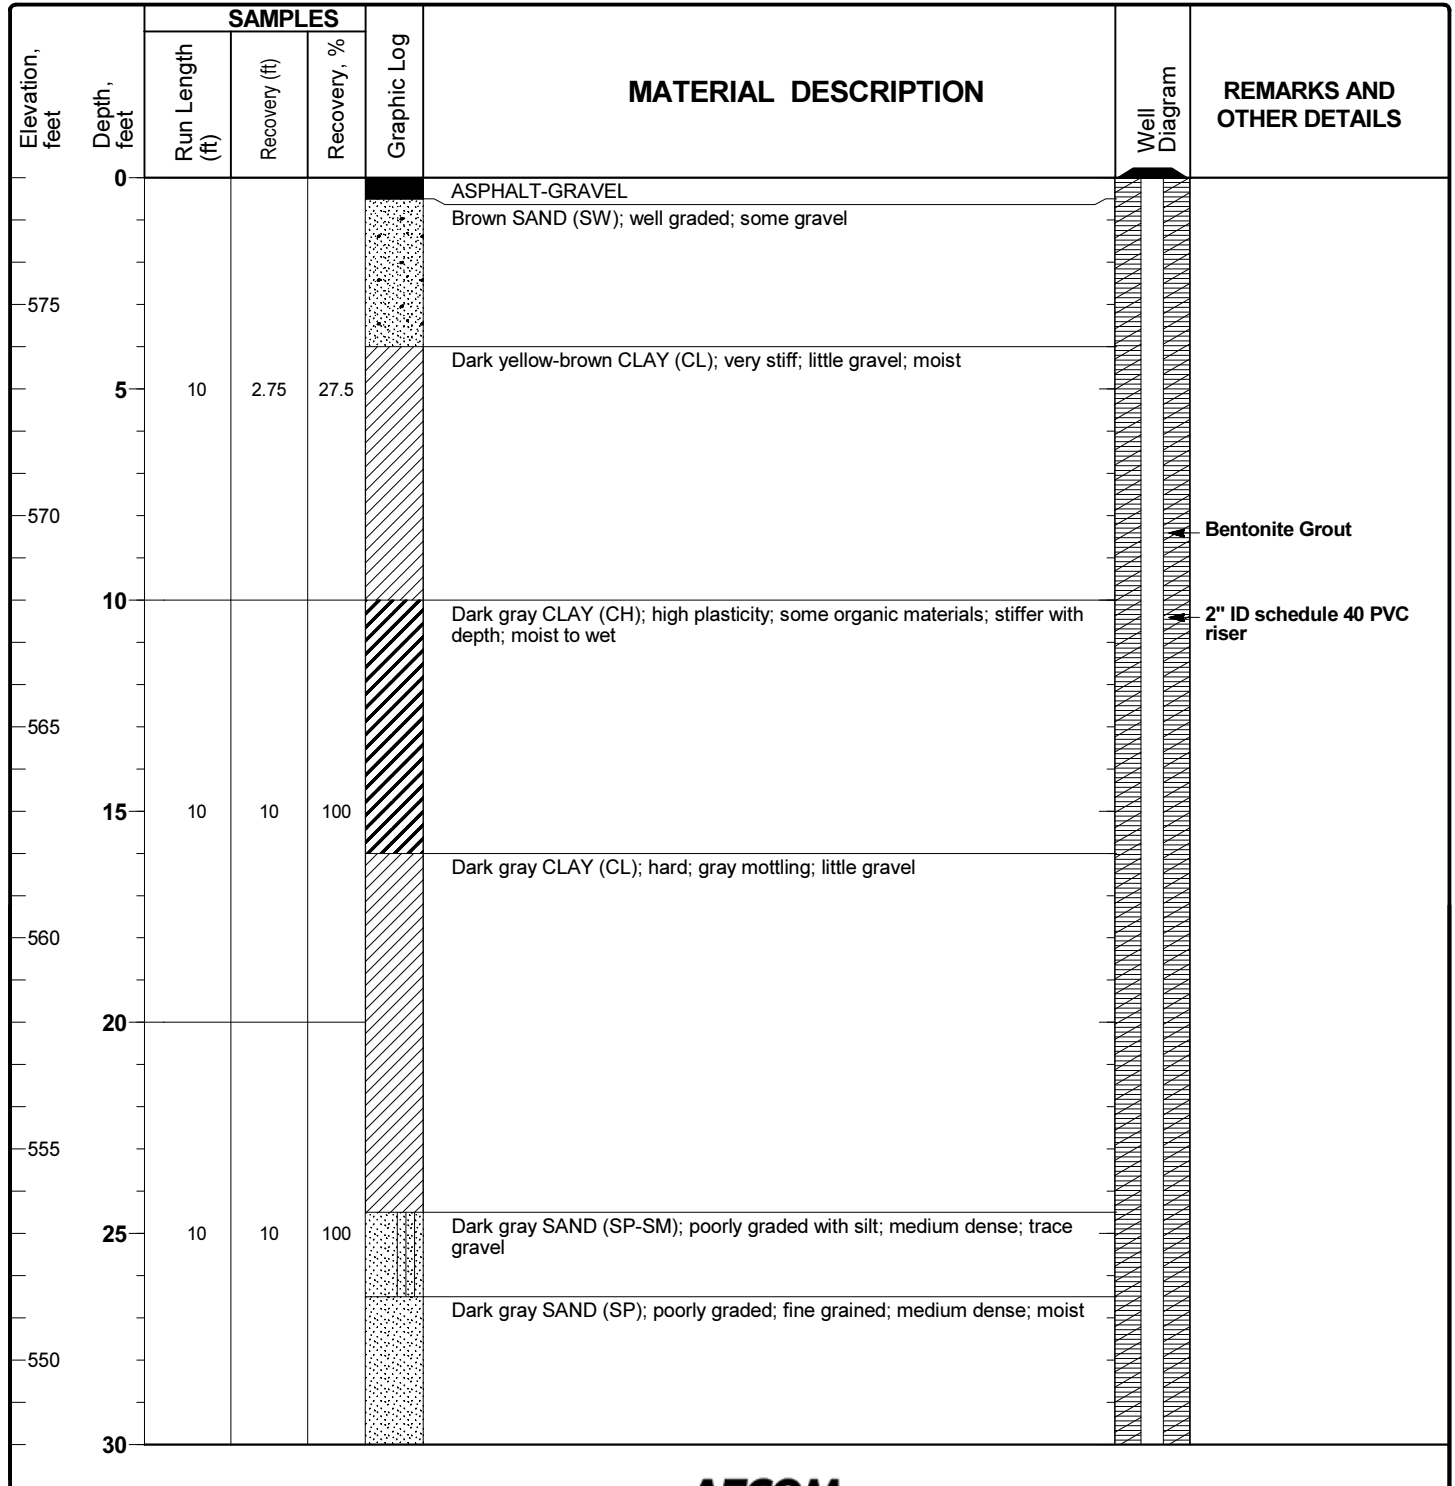

Report: DTE_MONROE; File J:\RESOURCE\DISCIPLINES\ENV\GINT\PROJECTS\DTE\MONROE_GRANVILLE_CLONE.GPJ; 3/24/2017 3:25:05 PM

Project: DTE Monroe Plant
Project Location: Monroe, Michigan
Project Number: 60489524

Log of MW-3D
 Sheet 2 of 3

MON
859

Elevation, feet	Depth, feet	SAMPLES			Graphic Log	MATERIAL DESCRIPTION	REMARKS AND OTHER DETAILS
		Run Length (ft)	Recovery (ft)	Recovery, %			
30							
545					Dark gray SAND (SP-SM); poorly graded with silt; fine grained; higher silt content at depth; wet		
35		10	9.5	95			
540					Gray SILT (ML); soft; little fine sand; wet	Bentonite Grout	
40					Dark gray CLAY (CL); glacial till; hard; trace gravel and sand; moist	2" ID schedule 40 PVC riser	
535							
45		10	5.5	55			
530							
50							
525							
55		10	5.5	55			
520							
60							
515		10	3.0	30	Gray highly weathered LIMESTONE (bedrock inclusion in till); some granite pebbles		
65					Dark gray CLAY (CL); glacial till; hard; trace gravel; moist	Bentonite Seal	

Report: DTE_MONROE; File J:\RESOURCES\DISCIPLINES\GINT\PROJECTS\DTE\MONROE_GRANVILLE_CLONE.GPJ; 3/24/2017 3:25:07 PM

Project: DTE Monroe Plant
Project Location: Monroe, Michigan
Project Number: 60489524

Log of MW-3D
 Sheet 3 of 3

MON
859

Elevation, feet	Depth, feet	SAMPLES			Graphic Log	MATERIAL DESCRIPTION	REMARKS AND OTHER DETAILS
		Run Length (ft)	Recovery (ft)	Recovery, %			
510	70	10	3.0	30	[Hatched pattern]	Bentonite Seal	
						2" ID schedule 40 PVC riser	
						SCH 40 PVC 2" Diameter 0.01" Slotted Screen	
505					[Horizontal line pattern]	Clean silica sand	
75		10	4.0	40	[Brick pattern]		
500							
80					[Brick pattern]	End of boring	
495							
85							
490							
90							
485							
95							
480							
100							

Report: DTE_MONROE; File J:\RESOURCES\DISCIPLINES\GINT\PROJECTS\DTE\MONROE_GRANVILLE_CLONE.GPJ; 3/24/2017 3:25:08 PM


Project: DTE Monroe Plant
Project Location: Monroe, Michigan
Project Number: 60489524

**Log of
 MW-3S**

Sheet 1 of 2

**MON
 860**

Date(s) Drilled	9/20/16 to 9/20/2016	Logged By	Ron Friend	Checked By	M Hawrylak
Drilling Method	Sonic	Drill Bit Size/Type	Sonic 6"	Total Depth of Borehole	40.0 ft
Drill Rig Type	Mini Sonic	Drilling Contractor	Cascade Drilling	Surface Elevation	578.1 ft msl
Borehole Backfill	Monitoring Well	Sampling Method(s)	Sonic Core Barrel - 4"	Top of Casing Elevation	577.58 ft msl
Boring Location	Inactive Bottom Ash Basin	Groundwater Level(s)	3.76' BTOC [Measurement after development]		

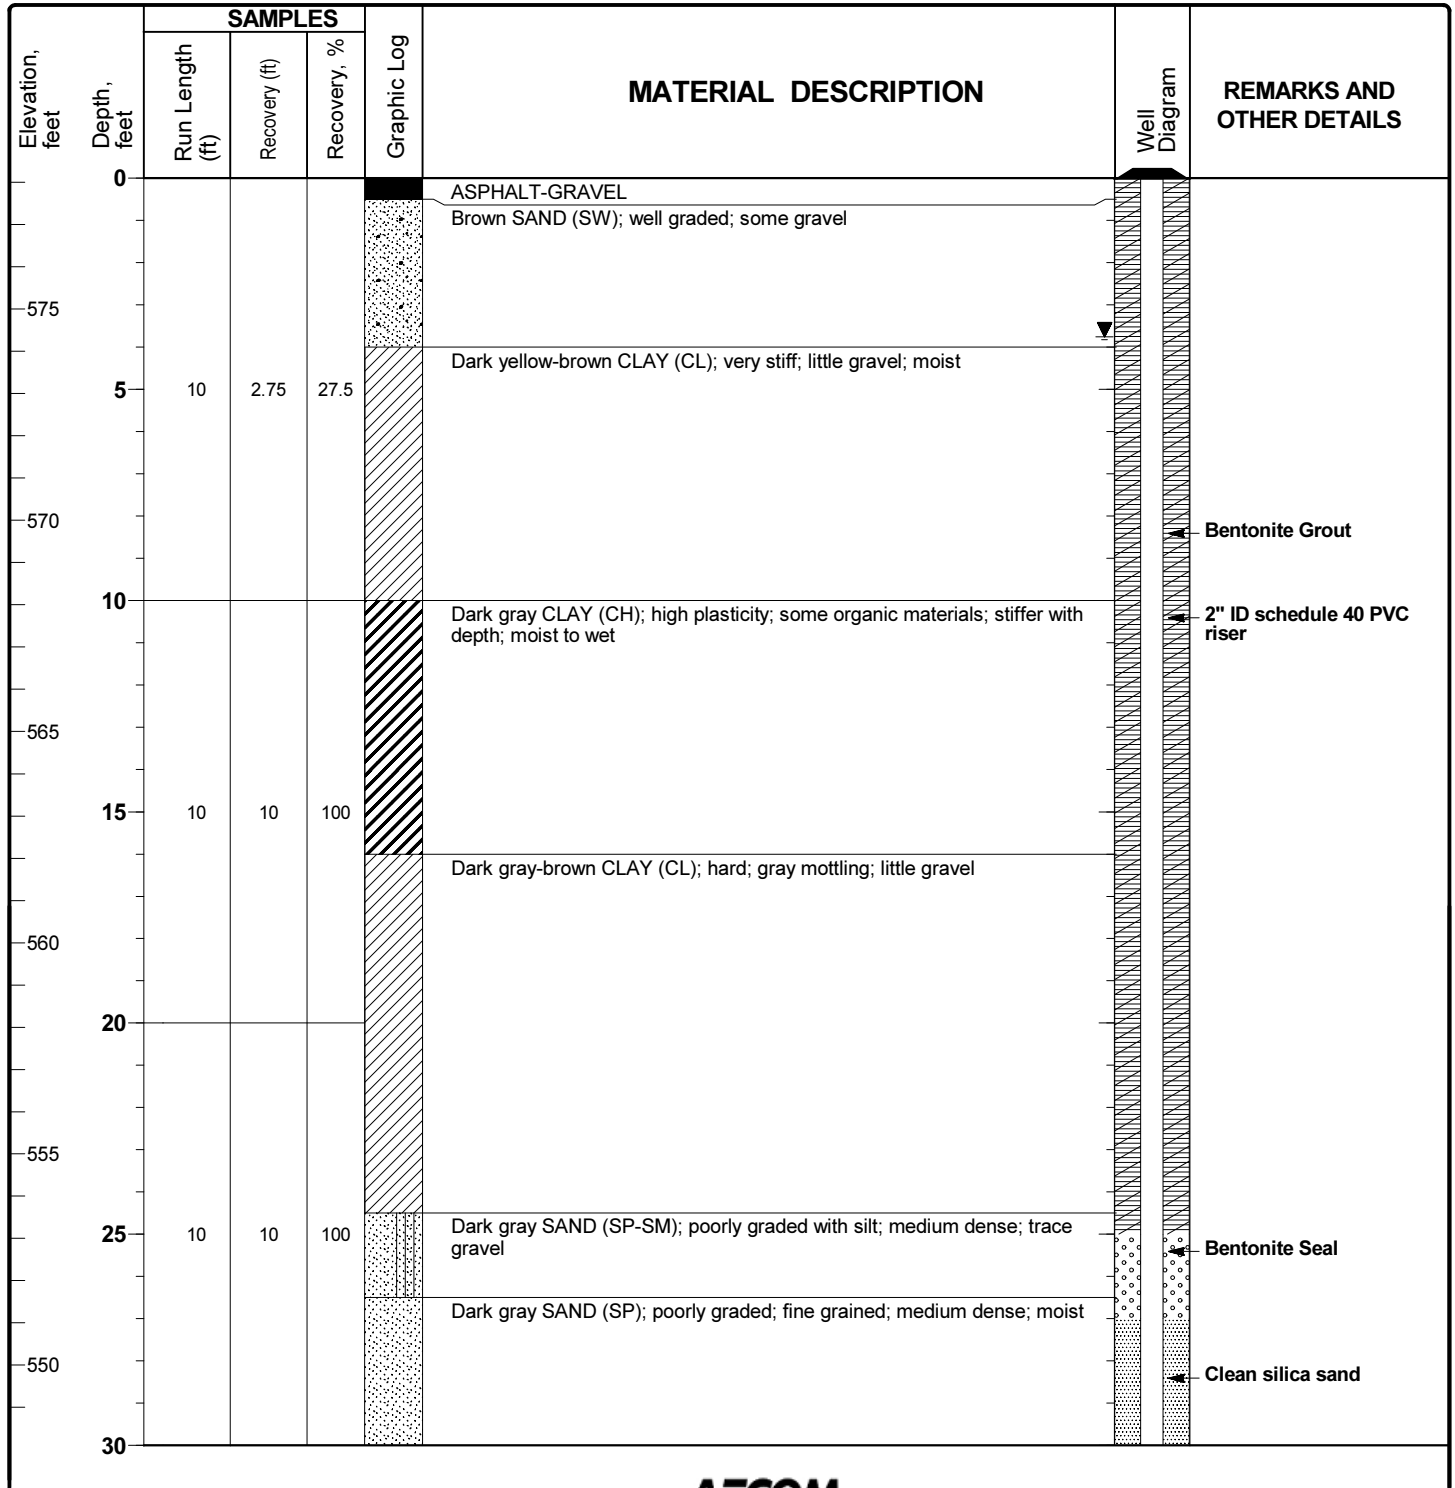

Report: DTE_MONROE; File J:\RESOURCE\DISCIPLINES\ENV\GINT\PROJECTS\DTE\MONROE_GRANVILLE CLONE.GPJ; 3/24/2017 3:25:16 PM

Project: DTE Monroe Plant
Project Location: Monroe, Michigan
Project Number: 60489524

Log of MW-3S
 Sheet 2 of 2


MON
860

Elevation, feet	Depth, feet	SAMPLES			Graphic Log	MATERIAL DESCRIPTION		REMARKS AND OTHER DETAILS
		Run Length (ft)	Recovery (ft)	Recovery, %				
30							SCH 40 PVC 2" Diameter 0.01" Slotted Screen	
545					Dark gray SAND (SP-SM); poorly graded with silt; fine grained; higher silt content at depth; wet		2" ID schedule 40 PVC riser	
35	10	9.5	95				Clean silica sand	
540					Gray SILT (ML); soft; little fine sand; wet			
40							End of boring	
535								
45	10	5.5	55					
530								
50								
525								
55								
520								
60								
515								
65								

Report: DTE_MONROE; File J:\RESOURCE\DISCIPLINES\ENV\GINT\PROJECTS\DTE\MONROE_GRANVILLE_CLONE.GPJ; 3/24/2017 3:25:18 PM

Project: DTE Monroe Plant	Log of MW-4S Sheet 1 of 2	MON 861
Project Location: Monroe, Michigan		
Project Number: 60489524		

Date(s) Drilled: 9/26/16 to 9/26/2016	Logged By: Ron Friend	Checked By: M Hawrylak
Drilling Method: Sonic	Drill Bit Size/Type: Sonic 6"	Total Depth of Borehole: 40.0 ft
Drill Rig Type: Mini Sonic	Drilling Contractor: Cascade Drilling	Surface Elevation: 578.1 ft msl
Borehole Backfill: Monitoring Well	Sampling Method(s): Sonic Core Barrel - 4"	Top of Casing Elevation: 580.67 ft msl
Boring Location: Inactive Bottom Ash Basin	Groundwater Level(s): 5.82' BTOC [Measurement after development]	

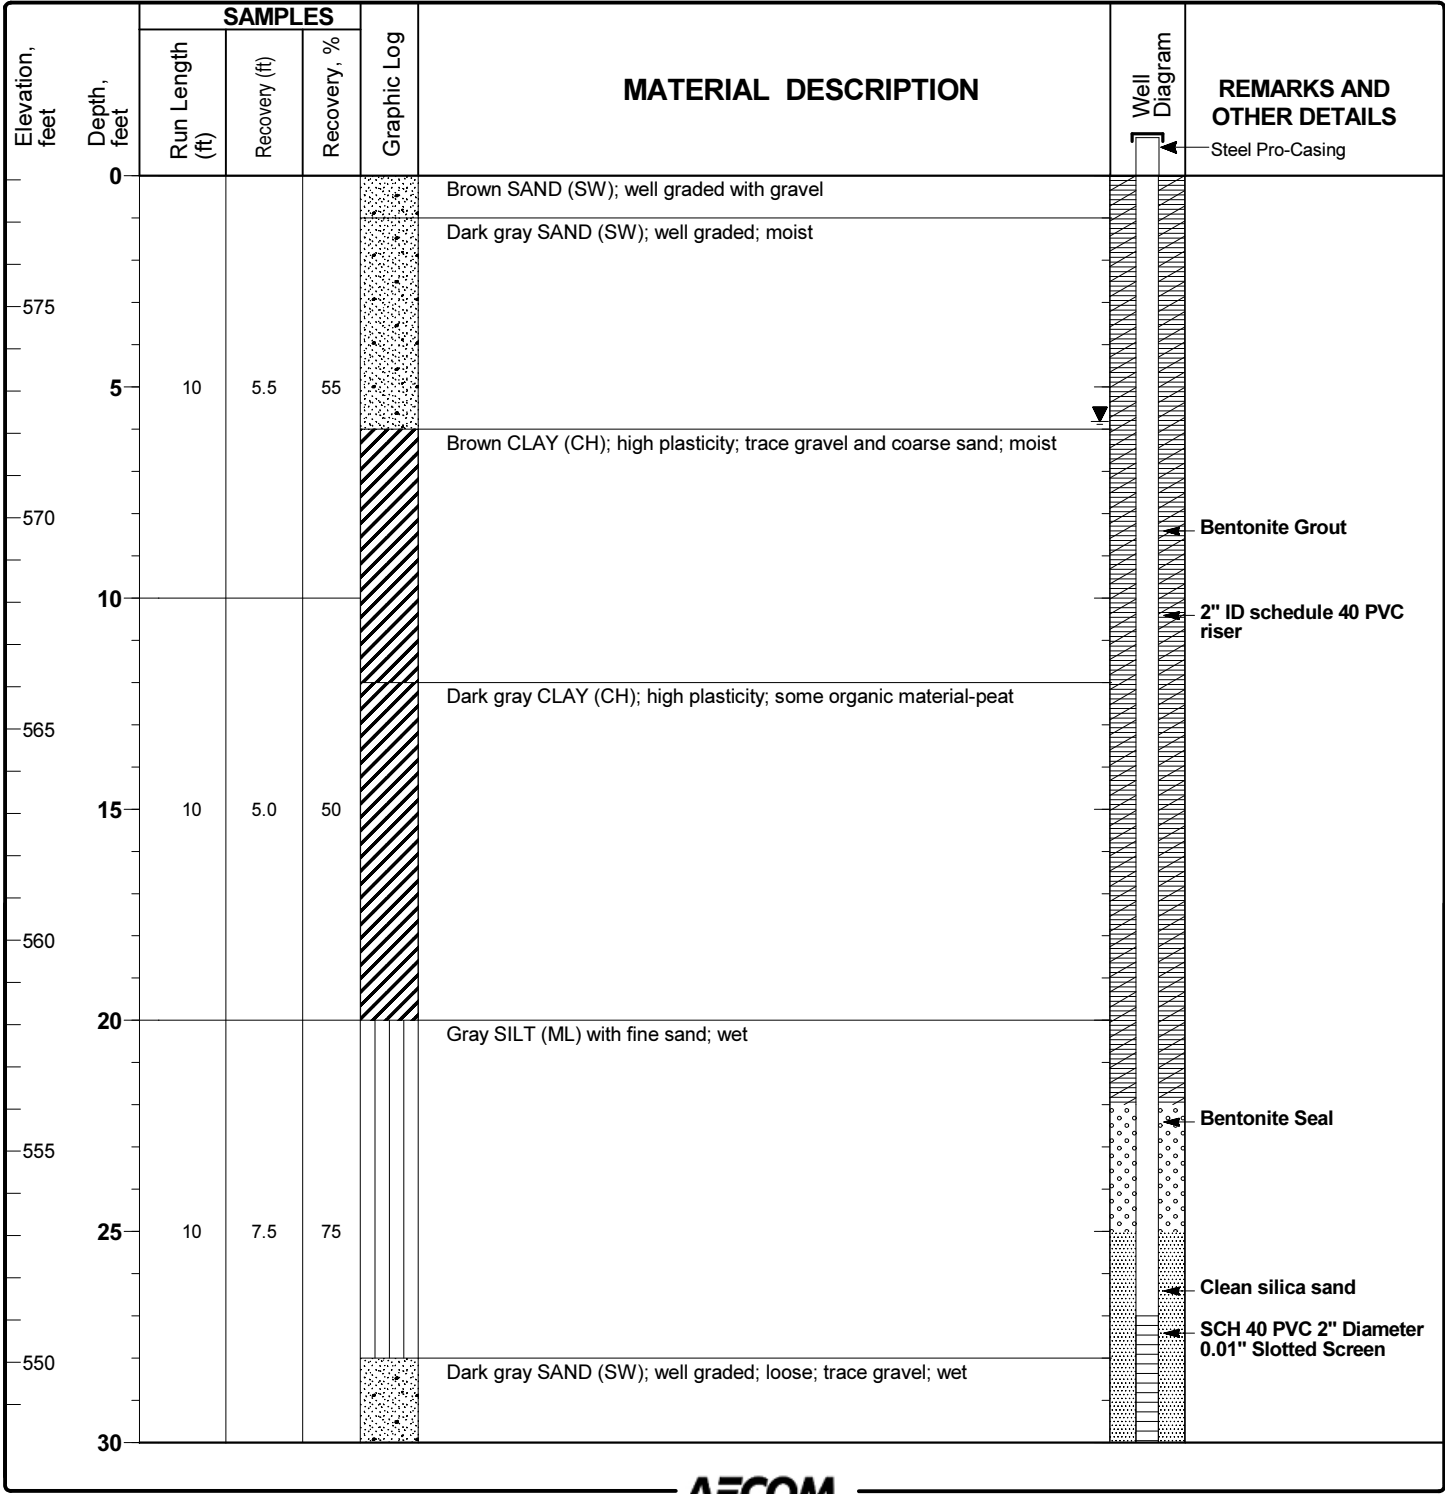

Report: DTE_MONROE; File J:\RESOURCE\DISCIPLINES\ENV\GINT\PROJECTS\DTE\MONROE_GRANVILLE_CLONE.GPJ; 3/24/2017 3:25:25 PM

Project: DTE Monroe Plant
Project Location: Monroe, Michigan
Project Number: 60489524

Log of MW-4S
 Sheet 2 of 2

MON 861

Elevation, feet	Depth, feet	SAMPLES			Graphic Log	MATERIAL DESCRIPTION		REMARKS AND OTHER DETAILS
		Run Length (ft)	Recovery (ft)	Recovery, %				
30							2" ID schedule 40 PVC riser	
545							SCH 40 PVC 2" Diameter 0.01" Slotted Screen	
35		10	7.5	75		Dark gray SILT (ML) with fine sand; wet	Clean silica sand	
540						Gray CLAY (CL); glacial till; hard; trace gravel and coarse sand	Bentonite Seal	
40							End of boring	
535								
45								
530								
50								
525								
55								
520								
60								
515								
65								

Report: DTE_MONROE; File J:\RESOURCE\DISCIPLINES\ENV\GINT\PROJECTS\DTE\MONROE_GRANVILLE_CLONE.GPJ; 3/24/2017 3:25:26 PM


Project: DTE Monroe Plant
Project Location: Monroe, Michigan
Project Number: 60489524

Log of MW-5S

Sheet 1 of 3

MON 862

Date(s) Drilled	10/4/16 to 10/4/2016	Logged By	Ron Friend	Checked By	M Hawrylak
Drilling Method	Sonic	Drill Bit Size/Type	Sonic 6"	Total Depth of Borehole	70.0 ft
Drill Rig Type	Mini Sonic	Drilling Contractor	Cascade Drilling	Surface Elevation	581.7 ft msl
Borehole Backfill	Monitoring Well	Sampling Method(s)	Sonic Core Barrel - 4"	Top of Casing Elevation	584.50 ft msl
Boring Location	Inactive Bottom Ash Basin	Groundwater Level(s)	5.81' BTOC [Measurement after development]		

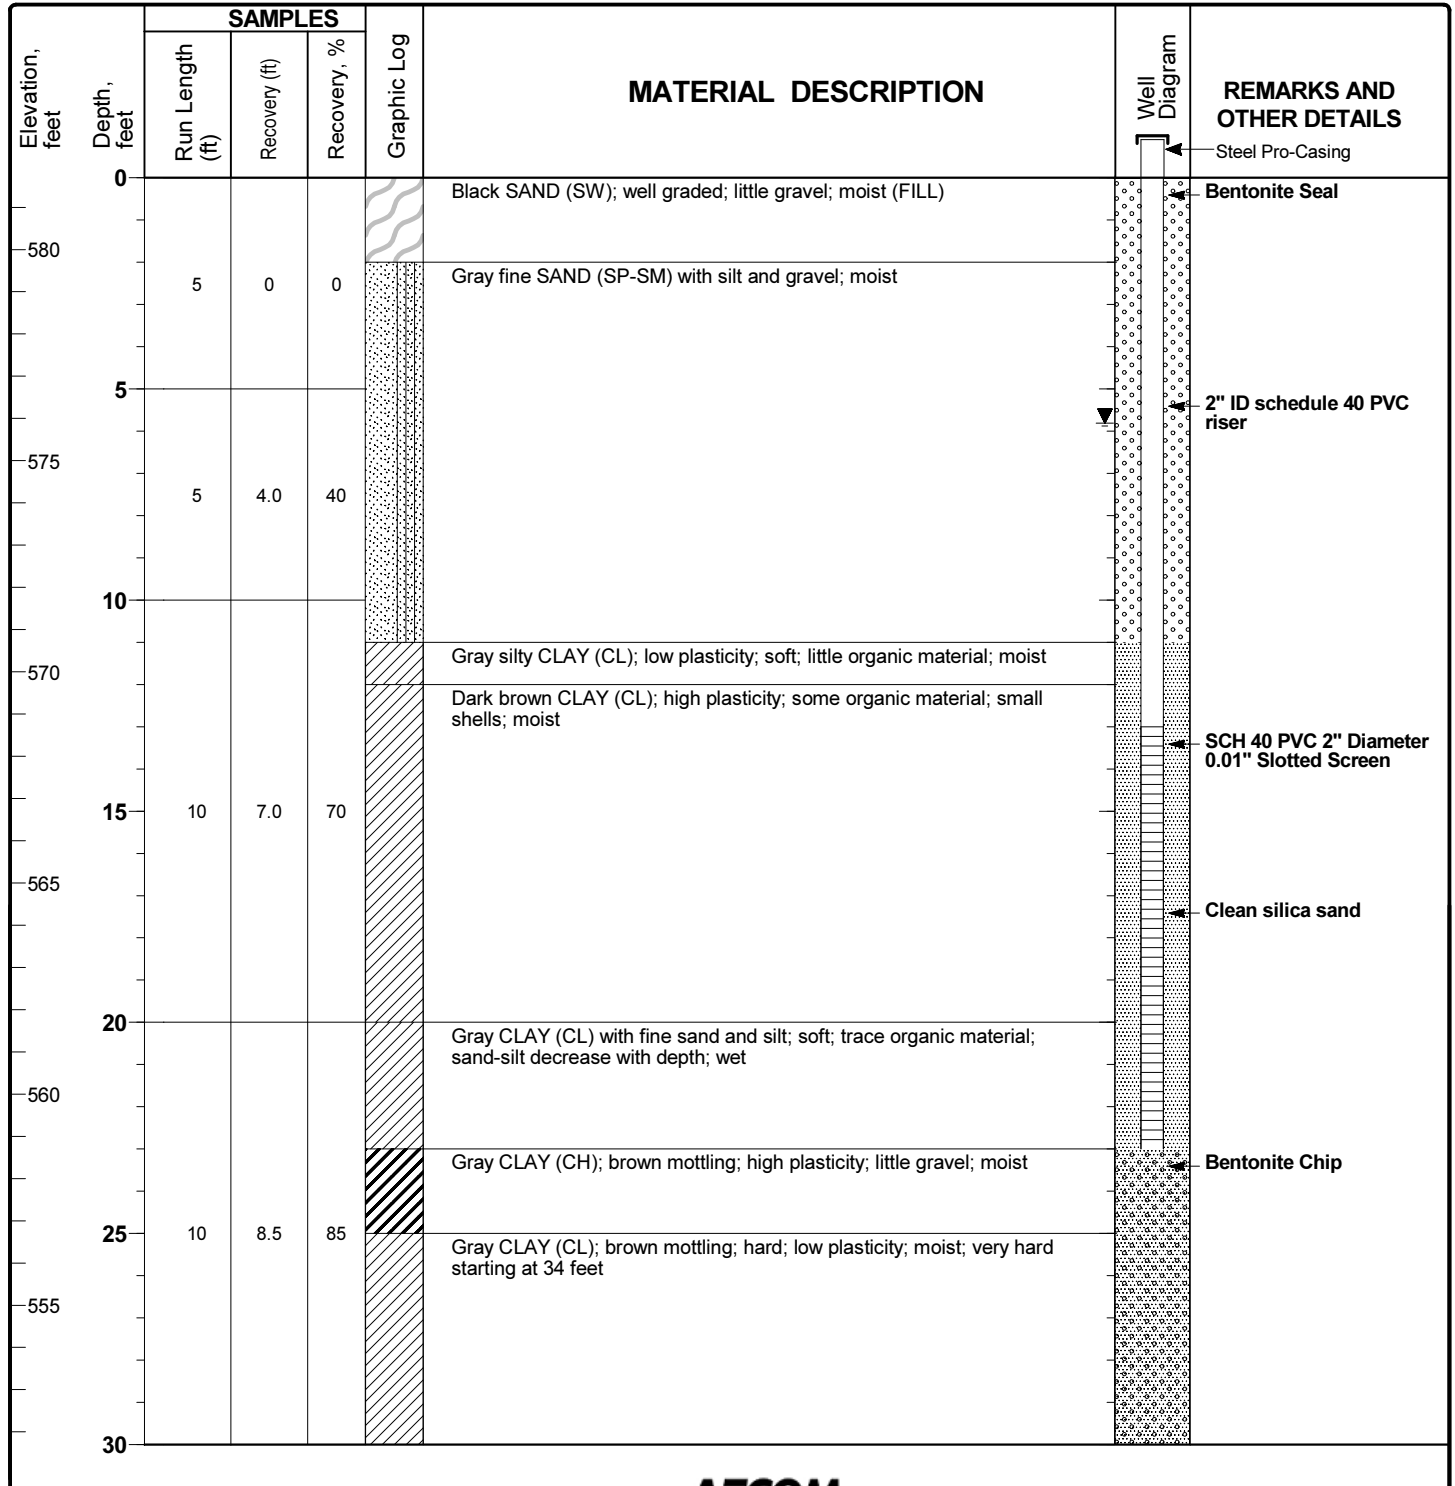

Report: DTE_MONROE; File J:\RESOURCE\DISCIPLINES\ENV\GINT\PROJECTS\IDTE\MONROE_GRANVILLE CLONE.GPJ; 3/24/2017 3:25:35 PM

Project: DTE Monroe Plant
Project Location: Monroe, Michigan
Project Number: 60489524

Log of MW-5S
 Sheet 2 of 3

MON 862



Elevation, feet	Depth, feet	SAMPLES			Graphic Log	MATERIAL DESCRIPTION	REMARKS AND OTHER DETAILS
		Run Length (ft)	Recovery (ft)	Recovery, %			
30							
550							
35		10	7.5	75			
545							
40							
540					Gray CLAY (CH); brown mottling; high plasticity; little gravel; moist	Bentonite Chip	
45		10	8.5	85			
535					Gray CLAY (CL); glacial till; very hard; moist to dry		
50							
530							
55		10	5.5	55			
525							
60							
520		5	4.0	80			
65							

Report: DTE_MONROE; File J:\RESOURCE\DISCIPLINES\ENV\GINT\PROJECTS\DTE\MONROE_GRANVILLE_CLONE.GPJ; 3/24/2017 3:25:36 PM

Project: DTE Monroe Plant
Project Location: Monroe, Michigan
Project Number: 60489524

**Log of
 MW-5S**
 Sheet 3 of 3

**MON
 862**

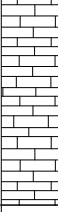Elevation, feet	Depth, feet	SAMPLES			Graphic Log	MATERIAL DESCRIPTION		REMARKS AND OTHER DETAILS
		Run Length (ft)	Recovery (ft)	Recovery, %				
515		5	4.0	80		Gray LIMESTONE (bedrock); highly weathered; dry from drilling methods but zone produces water		Bentonite Chip
70								End of boring
510								
75								
505								
80								
500								
85								
495								
90								
490								
95								
485								
100								

Report: DTE_MONROE; File J:\RESOURCE\DISCIPLINES\ENV\GINT\PROJECTS\DTE\MONROE_GRANVILLE_CLONE.GPJ; 3/24/2017 3:25:37 PM


Project: DTE Monroe Plant
Project Location: Monroe, Michigan
Project Number: 60489524

**Log of
 MW-7D**

Sheet 1 of 3

**MON
 863**

Date(s) Drilled	9/28/16 to 9/28/2016	Logged By	Ron Friend	Checked By	M Hawrylak
Drilling Method	Sonic	Drill Bit Size/Type	Sonic 6"	Total Depth of Borehole	70.0 ft
Drill Rig Type	Mini Sonic	Drilling Contractor	Cascade Drilling	Surface Elevation	576.7 ft msl
Borehole Backfill	Monitoring Well	Sampling Method(s)	Sonic Core Barrel - 4"	Top of Casing Elevation	576.17 ft msl
Boring Location	Inactive Bottom Ash Basin	Groundwater Level(s)	Artesian (flowing) [Measurement after development]		

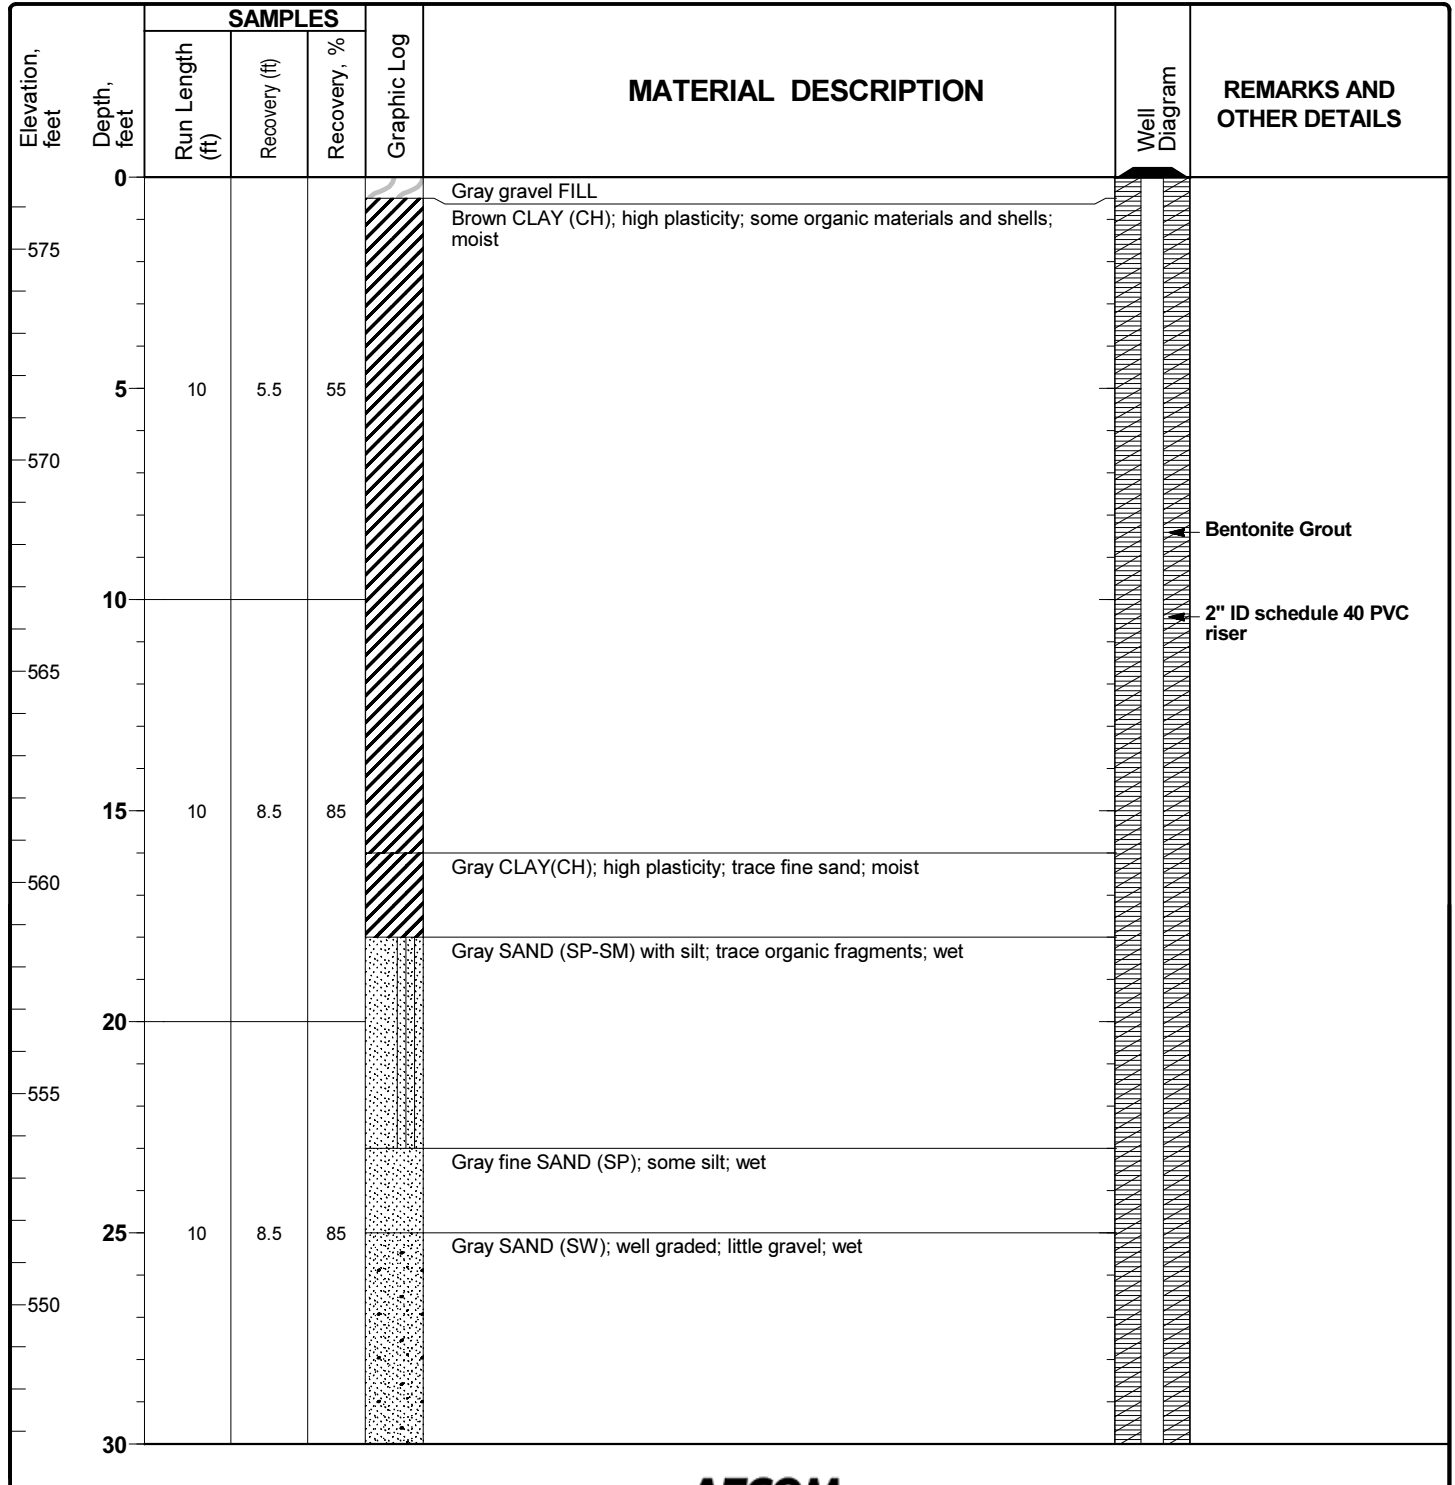

Report: DTE_MONROE; File J:\RESOURCE\DISCIPLINES\GINT\PROJECTS\DTE\MONROE_GRANVILLE CLONE.GPJ; 3/24/2017 3:25:50 PM

Project: DTE Monroe Plant
Project Location: Monroe, Michigan
Project Number: 60489524

Log of MW-7D
 Sheet 2 of 3

MON
863



Elevation, feet	Depth, feet	SAMPLES			Graphic Log	MATERIAL DESCRIPTION	REMARKS AND OTHER DETAILS
		Run Length (ft)	Recovery (ft)	Recovery, %			
30							
545					Gray GRAVEL (GW); well graded with sand; wet		
					Gray SAND (SW); well graded; little gravel; wet		
35	10	8.5	85		Dark gray CLAY (CL); glacial till; hard; trace gravel and coarse sand; moist		
540							
40						Bentonite Grout	
535						2" ID schedule 40 PVC riser	
45	10	9.5	95				
530							
50							
525							
55	10	10	100		Light gray LIMESTONE (bedrock); highly weathered; some larger pieces; wet	Bentonite Seal	
520							
60					Light gray LIMESTONE (bedrock); highly weathered; some intact pieces; poor recovery overall; wet	SCH 40 PVC 2" Diameter 0.01" Slotted Screen	
515							
65	10	2.5	25			Clean silica sand	

Report: DTE_MONROE; File J:\RESOURCE\DISCIPLINES\GINT\PROJECTS\DTE\MONROE_GRANVILLE CLONE.GPJ; 3/24/2017 3:25:51 PM

Project: DTE Monroe Plant
Project Location: Monroe, Michigan
Project Number: 60489524

Log of MW-7D
 Sheet 3 of 3

MON
863

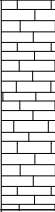Elevation, feet	Depth, feet	SAMPLES			Graphic Log	MATERIAL DESCRIPTION		REMARKS AND OTHER DETAILS
		Run Length (ft)	Recovery (ft)	Recovery, %				
510		10	2.5	25			2" ID schedule 40 PVC riser SCH 40 PVC 2" Diameter 0.01" Slotted Screen Clean silica sand Collapse	
70							End of boring	
505								
75								
500								
80								
495								
85								
490								
90								
485								
95								
480								
100								

Report: DTE_MONROE; File J:\RESOURCE\DISCIPLINES\ENV\GINT\PROJECTS\DTE\MONROE_GRANVILLE_CLONE.GPJ; 3/24/2017 3:25:53 PM


Project: DTE Monroe Plant
Project Location: Monroe, Michigan
Project Number: 60489524

Log of MW-7S

Sheet 1 of 2

MON 864

Date(s) Drilled	9/28/16 to 9/28/2016	Logged By	Ron Friend	Checked By	M Hawrylak
Drilling Method	Sonic	Drill Bit Size/Type	Sonic 6"	Total Depth of Borehole	34.0 ft
Drill Rig Type	Mini Sonic	Drilling Contractor	Cascade Drilling	Surface Elevation	576.6 ft msl
Borehole Backfill	Monitoring Well	Sampling Method(s)	Sonic Core Barrel - 4"	Top of Casing Elevation	576.20 ft msl
Boring Location	Inactive Bottom Ash Basin	Groundwater Level(s)	2.74' BTOC [Measurement after development]		


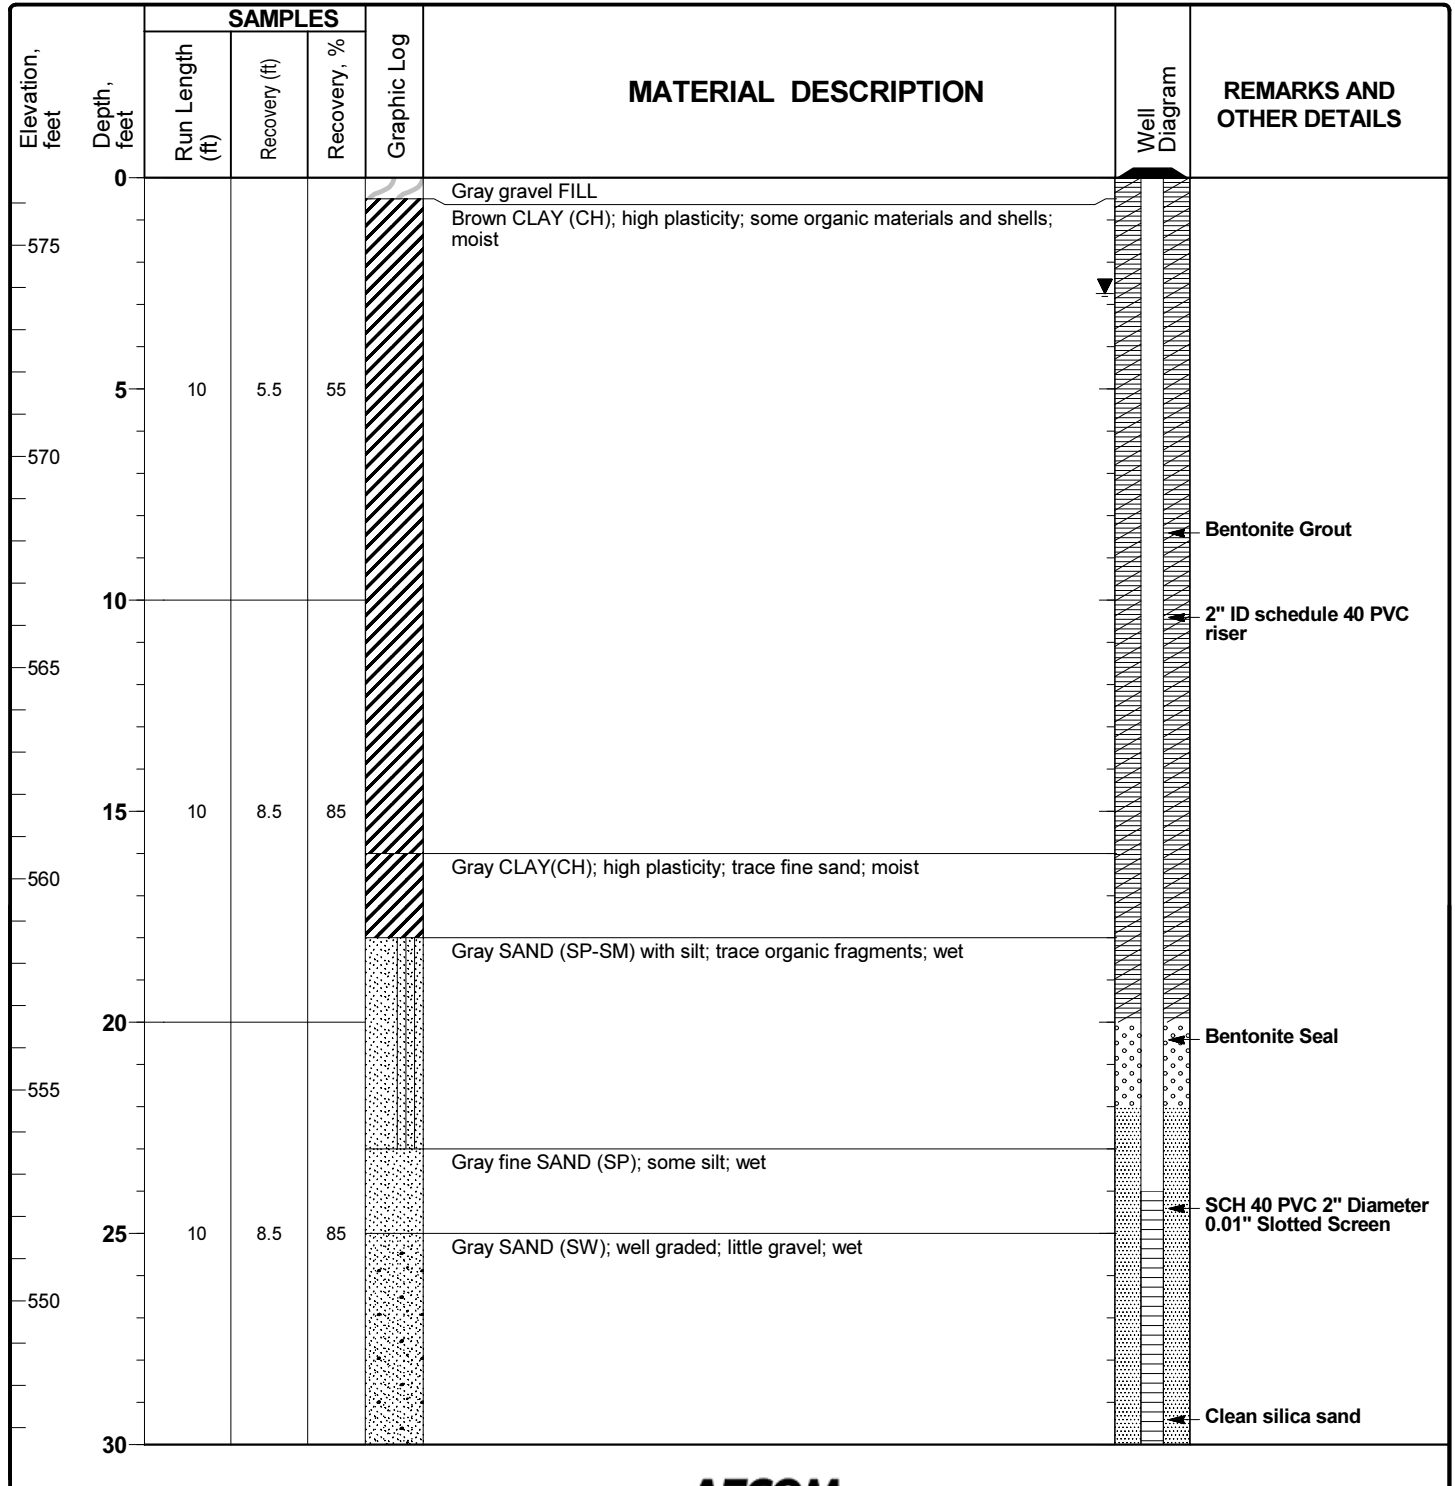


Report: DTE_MONROE; File J:\RESOURCE\DISCIPLINES\ENV\GINT\PROJECTS\DTE\MONROE_GRANVILLE CLONE.GPJ; 3/24/2017 3:26:01 PM

Project: DTE Monroe Plant
Project Location: Monroe, Michigan
Project Number: 60489524

Log of MW-7S
 Sheet 2 of 2


MON
864

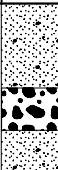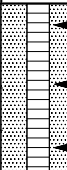Elevation, feet	Depth, feet	SAMPLES			Graphic Log	MATERIAL DESCRIPTION		REMARKS AND OTHER DETAILS
		Run Length (ft)	Recovery (ft)	Recovery, %				
30								
545		4	3.4	85		Gray GRAVEL (GW); well graded with sand; wet Gray SAND (SW); well graded; little gravel; wet	 2" ID schedule 40 PVC riser SCH 40 PVC 2" Diameter 0.01" Slotted Screen Clean silica sand	
35							End of boring	
540								
40								
535								
45								
530								
50								
525								
55								
520								
60								
515								
65								

Report: DTE_MONROE; File J:\RESOURCE\DISCIPLINES\ENV\GINT\PROJECTS\IDTE\MONROE_GRANVILLE CLONE.GPJ; 3/24/2017 3:26:02 PM

Project: DTE Monroe Plant	Log of MW-8D Sheet 1 of 3	MON 865
Project Location: Monroe, Michigan		
Project Number: 60489524		

Date(s) Drilled: 9/29/16 to 9/30/2016	Logged By: Ron Friend	Checked By: M Hawrylak
Drilling Method: Sonic	Drill Bit Size/Type: Sonic 6"	Total Depth of Borehole: 70.0 ft
Drill Rig Type: Mini Sonic	Drilling Contractor: Cascade Drilling	Surface Elevation: 583.7 ft msl
Borehole Backfill: Monitoring Well	Sampling Method(s): Sonic Core Barrel - 4"	Top of Casing Elevation: 586.45 ft msl
Boring Location: Fly Ash Basin	Groundwater Level(s): Artesian (flowing) [Measurement after development]	

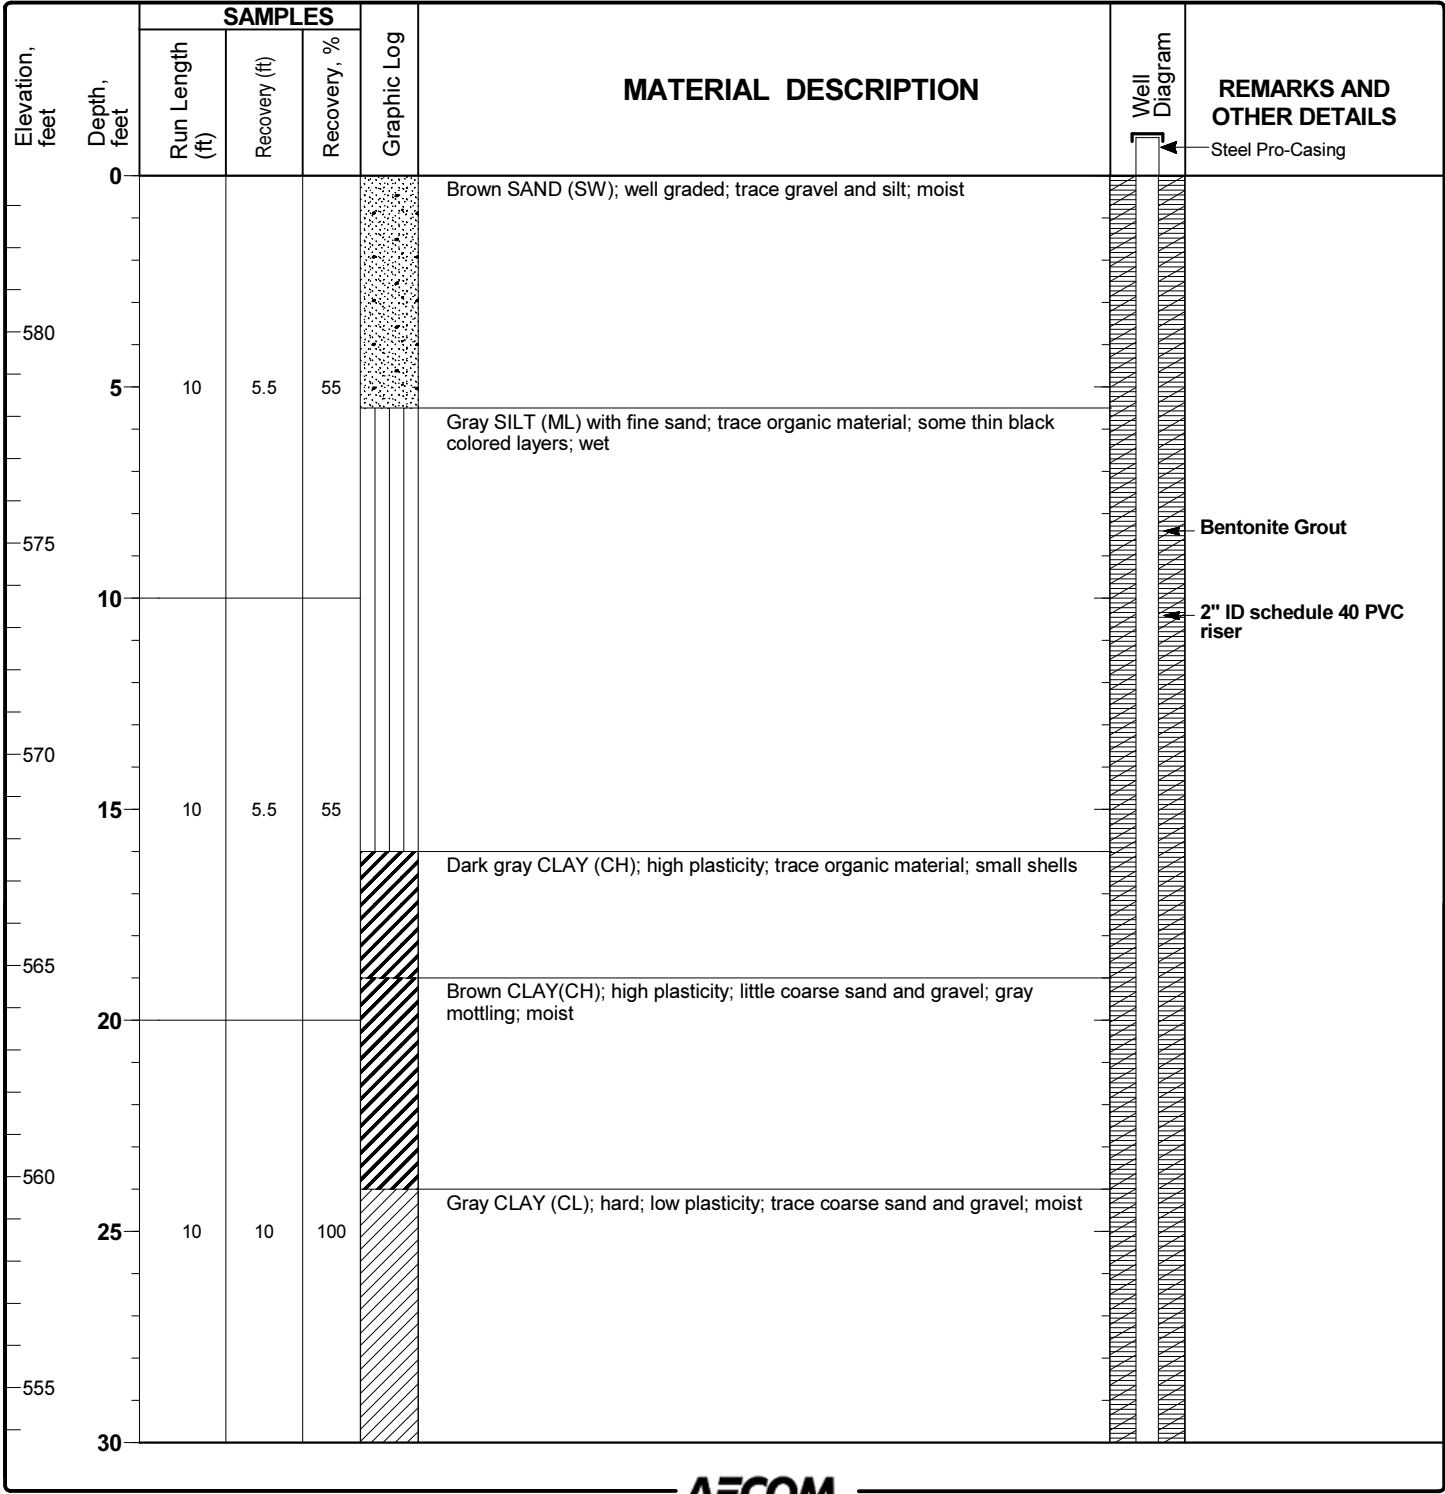

Report: DTE_MONROE; File J:\RESOURCE\DISCIPLINES\ENV\GINT\PROJECTS\DTE\MONROE_GRANVILLE_CLONE.GPJ; 3/24/2017 3:26:11 PM

Project: DTE Monroe Plant
Project Location: Monroe, Michigan
Project Number: 60489524

Log of MW-8D

Sheet 2 of 3

MON
865


Elevation, feet	Depth, feet	SAMPLES			Graphic Log	MATERIAL DESCRIPTION	REMARKS AND OTHER DETAILS
		Run Length (ft)	Recovery (ft)	Recovery, %			
30		5	5	100			
550							
35		5	2.5	50	Gray fine SAND (SP-SM) with silt; thin silt seams (<1" thick); wet		
545						Bentonite Grout	
40						2" ID schedule 40 PVC riser	
540					Gray CLAY (CL); hard; glacial till; med-low plasticity; little gravel and coarse sand; moist		
45		10	8.0	80			
535							
50							
530					Light gray LIMESTONE (bedrock); highly weathered; soft; wet	Bentonite Seal	
55		10	8.0	80			
525					Brown LIMESTONE (bedrock); weathered; wet	SCH 40 PVC 2" Diameter 0.01" Slotted Screen	
60							
520		10	2.0	20		Clean silica sand	
65							

Report: DTE_MONROE; File J:\RESOURCE\DISCIPLINES\GINT\PROJECTS\DTE\MONROE_GRANVILLE CLONE.GPJ; 3/24/2017 3:26:12 PM

Project: DTE Monroe Plant
Project Location: Monroe, Michigan
Project Number: 60489524

Log of MW-8D
 Sheet 3 of 3

MON
865

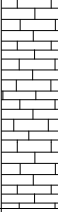Elevation, feet	Depth, feet	SAMPLES			Graphic Log	MATERIAL DESCRIPTION	REMARKS AND OTHER DETAILS
		Run Length (ft)	Recovery (ft)	Recovery, %			
515	70	10	2.0	20		<ul style="list-style-type: none"> ← 2" ID schedule 40 PVC riser ← SCH 40 PVC 2" Diameter 0.01" Slotted Screen ← Clean silica sand 	
510	75					End of boring	
505	80						
500	85						
495	90						
490	95						
485							
100							

Report: DTE_MONROE; File J:\RESOURCES\DISCIPLINES\GINT\PROJECTS\DTE\MONROE_GRANVILLE_CLONE.GPJ; 3/24/2017 3:26:14 PM


Project: DTE Monroe Plant
Project Location: Monroe, Michigan
Project Number: 60489524

**Log of
 MW-8S**

Sheet 1 of 2

**MON
 866**

Date(s) Drilled	9/29/16 to 9/30/2016	Logged By	Ron Friend	Checked By	M Hawrylak
Drilling Method	Sonic	Drill Bit Size/Type	Sonic 6"	Total Depth of Borehole	43.0 ft
Drill Rig Type	Mini Sonic	Drilling Contractor	Cascade Drilling	Surface Elevation	583.7 ft msl
Borehole Backfill	Monitoring Well	Sampling Method(s)	Sonic Core Barrel - 4"	Top of Casing Elevation	586.59 ft msl
Boring Location	Fly Ash Basin	Groundwater Level(s)	11.86' BTOC [Measurement after development]		

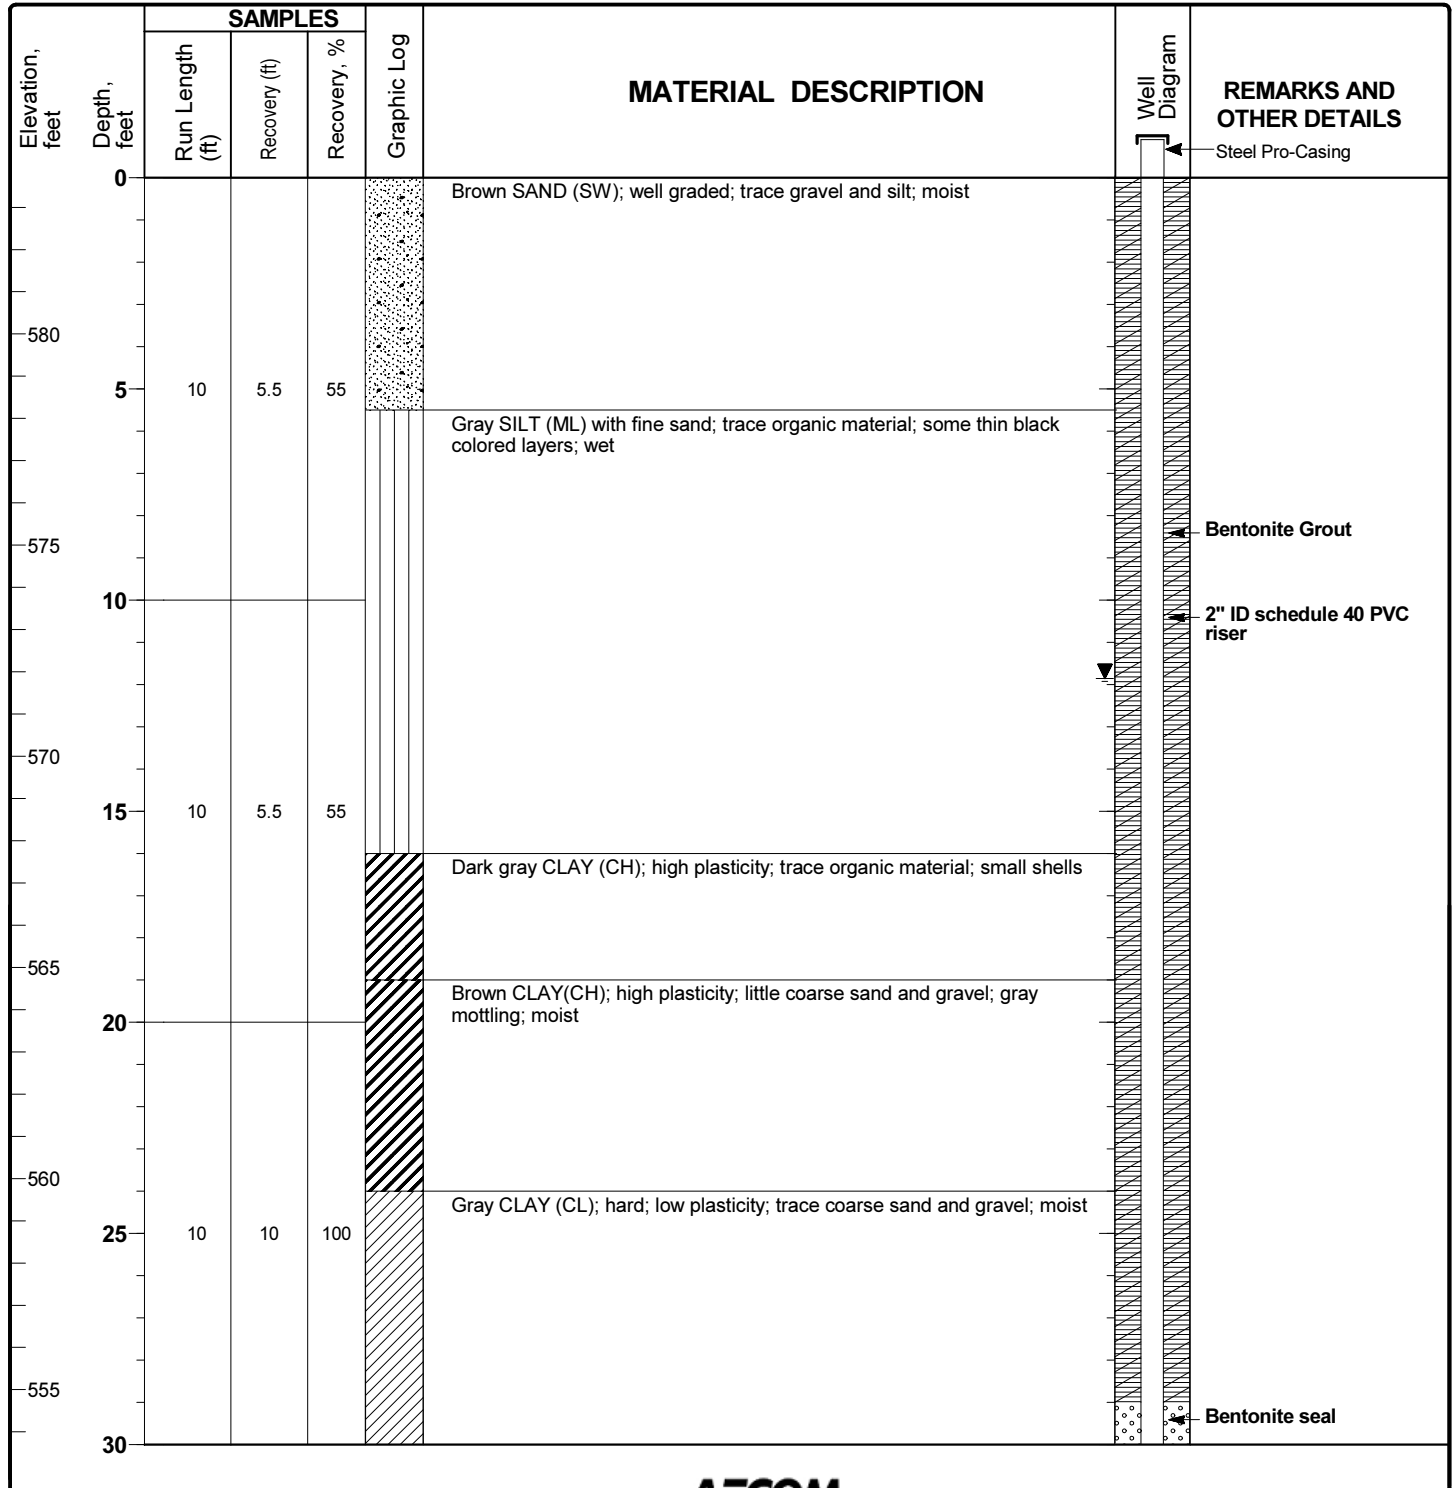

Report: DTE_MONROE; File J:\RESOURCE\DISCIPLINES\ENV\GINT\PROJECTS\DTE\MONROE_GRANVILLE CLONE.GPJ; 3/24/2017 3:26:21 PM

Project: DTE Monroe Plant
Project Location: Monroe, Michigan
Project Number: 60489524

Log of MW-8S
 Sheet 2 of 2

MON 866

Elevation, feet	Depth, feet	SAMPLES			Graphic Log	MATERIAL DESCRIPTION	REMARKS AND OTHER DETAILS
		Run Length (ft)	Recovery (ft)	Recovery, %			
30							Bentonite seal 2" ID schedule 40 PVC riser
550		5	5	100			SCH 40 PVC 2" Diameter 0.01" Slotted Screen
35						Gray fine SAND (SP-SM) with silt; thin silt seams (<1" thick); wet	
545		5	2.5	50			Clean silica sand
40							
540		3	2.4	80			
45							End of boring
535							
50							
530							
55							
525							
60							
520							
65							

Report: DTE_MONROE; File J:\RESOURCES\DISCIPLINES\ENV\GINT\PROJECTS\IDTE\MONROE_GRANVILLE_CLONE.GPJ; 3/24/2017 3:26:22 PM

Project: DTE Monroe Plant
Project Location: Monroe, Michigan
Project Number: 60489524

Log of SB-5

Sheet 1 of 3

MON
867

Date(s) Drilled	9/27/16 to 9/27/2016	Logged By	Ron Friend	Checked By	M Hawrylak
Drilling Method	Sonic	Drill Bit Size/Type	Sonic 6"	Total Depth of Borehole	70.0 ft
Drill Rig Type	Mini Sonic	Drilling Contractor	Cascade Drilling	Surface Elevation	ft msl
Borehole Backfill	Monitoring Well	Sampling Method(s)	Sonic Core Barrel - 4"	Top of Casing Elevation	ft msl
Boring Location	Inactive Bottom Ash Basin	Groundwater Level(s)	N/A		



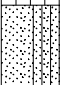
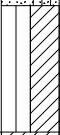




Depth, feet	SAMPLES			Graphic Log	MATERIAL DESCRIPTION	Well Diagram	REMARKS AND OTHER DETAILS
	Run Length (ft)	Recovery (ft)	Recovery, %				
0					Dark brown SAND (SW); well graded; trace gravel; small pieces of coal (FILL)		
5	10	7.0	70		Gray fine SAND (SP); poorly sorted; some silt; moist to wet; water odor (strong organic decay-like smell) starting at (FILL)		
10							
15	10	7.5	75				
20							
25	10	2.0	20				
30							

Report: DTE_MONROE; File J:\RESOURCE\DISCIPLINES\ENV\GINT\PROJECTS\IDTE\MONROE_GRANVILLE CLONE.GPJ; 3/24/2017 3:26:27 PM

Project: DTE Monroe Plant
Project Location: Monroe, Michigan
Project Number: 60489524

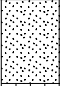Log of SB-5
 Sheet 2 of 3

MON
867


Depth, feet	SAMPLES			Graphic Log	MATERIAL DESCRIPTION	REMARKS AND OTHER DETAILS
	Run Length (ft)	Recovery (ft)	Recovery, %			
30					Dark gray SILT (ML); soft; some clay; wet	
35	10	8.5	85		Gray fine SAND (SP-SM) with silt; trace organic fragments; wet	
40					Gray SILT (CL-ML) with clay; low plasticity; gravel at 39'; wet	
45	10	6.5	65		Dary gray CLAY (CL); glacial till; trace gravel and coarse sand; moist	
50						
55	10	7.5	75			
60						
65	10	4.5	45		Gray LIMESTONE (bedrock); highly weathered; ground up during drilling to gravel size chunks; wet	

Report: DTE_MONROE; File J:\RESOURCE\DISCIPLINES\ENV\GINT\PROJECTS\IDTE\MONROE_GRANVILLE_CLONE.GPJ; 3/24/2017 3:26:28 PM

Project: DTE Monroe Plant
Project Location: Monroe, Michigan
Project Number: 60489524

Log of SB-5
 Sheet 3 of 3

MON
867

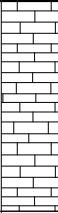Depth, feet	SAMPLES			Graphic Log	MATERIAL DESCRIPTION	REMARKS AND OTHER DETAILS
	Run Length (ft)	Recovery (ft)	Recovery, %			
70	10	4.5	45			
75						
80						
85						
90						
95						
100						End of boring




Project: DTE Monroe Plant
Project Location: Monroe, Michigan
Project Number: 60489524

Log of SB-6

Sheet 1 of 3

MON
868

Date(s) Drilled	9/22/16 to 9/22/2016	Logged By	Ron Friend	Checked By	M Hawrylak
Drilling Method	Sonic	Drill Bit Size/Type	Sonic 6"	Total Depth of Borehole	80.0 ft
Drill Rig Type	Mini Sonic	Drilling Contractor	Cascade Drilling	Surface Elevation	ft msl
Borehole Backfill	Monitoring Well	Sampling Method(s)	Sonic Core Barrel - 4"	Top of Casing Elevation	ft msl
Boring Location	Inactive Bottom Ash Basin	Groundwater Level(s)	N/A		




Depth, feet	SAMPLES			Graphic Log	MATERIAL DESCRIPTION	Well Diagram	REMARKS AND OTHER DETAILS
	Run Length (ft)	Recovery (ft)	Recovery, %				
0					Gray Gravel (FILL-berm materials); loose; little sand and silt; wet @ 3 feet		
5	10	4.0	40				
10					Dark gray CLAY (CH); soft; with some ash; high plasticity; moist-wet; some fill material		
15	10	8.25	82.5				
20							
25	10	7.5	75				
30					Dark gray CLAY (CH); hard; med-high plasticity; trace coarse sand and gravel; moist		

Report: DTE_MONROE; File J:\RESOURCE\DISCIPLINES\ENV\GINT\PROJECTS\DTE\MONROE_GRANVILLE_CLONE.GPJ; 3/24/2017 3:26:36 PM

Project: DTE Monroe Plant
Project Location: Monroe, Michigan
Project Number: 60489524

Log of SB-6
 Sheet 2 of 3

MON
868


Depth, feet	SAMPLES			Graphic Log	MATERIAL DESCRIPTION	REMARKS AND OTHER DETAILS
	Run Length (ft)	Recovery (ft)	Recovery, %			
30						
35	10	10	100			
40						
45	10	8.5	85		Dark gray CLAY (CL); hard; low plasticity; trace coarse sand and gravel; moist	
50						
55	5	4.5	90			
60						
65	10	6.0	60		Light gray LIMESTONE (bedrock); highly weathered; some intact pieces 1"-3" long; moist to dry	

Report: DTE_MONROE; File J:\RESOURCE\DISCIPLINES\ENV\GINT\PROJECTS\DTE\MONROE_GRANVILLE CLONE.GPJ; 3/24/2017 3:26:37 PM

Project: DTE Monroe Plant
Project Location: Monroe, Michigan
Project Number: 60489524

Log of SB-6
 Sheet 3 of 3


MON
868

Depth, feet	SAMPLES			Graphic Log	MATERIAL DESCRIPTION	REMARKS AND OTHER DETAILS
	Run Length (ft)	Recovery (ft)	Recovery, %			
70	10	6.0	60		Gray LIMESTONE (bedrock); some weathering; staining on fractures; some intact pieces 2"-3" long; wet	
75	10	7.0	70		Gray LIMESTONE (bedrock); highly weathered; wet	
80					Gray LIMESTONE (bedrock); some weathering; staining on fractures; some intact pieces 2"-3" long; wet	
85						End of boring
90						
95						
100						

Report: DTE_MONROE; File J:\RESOURCE\DISCIPLINES\ENV\GINT\PROJECTS\DTE\MONROE_GRANVILLE_CLONE.GPJ; 3/24/2017 3:26:38 PM

Appendix B

Cross Sections

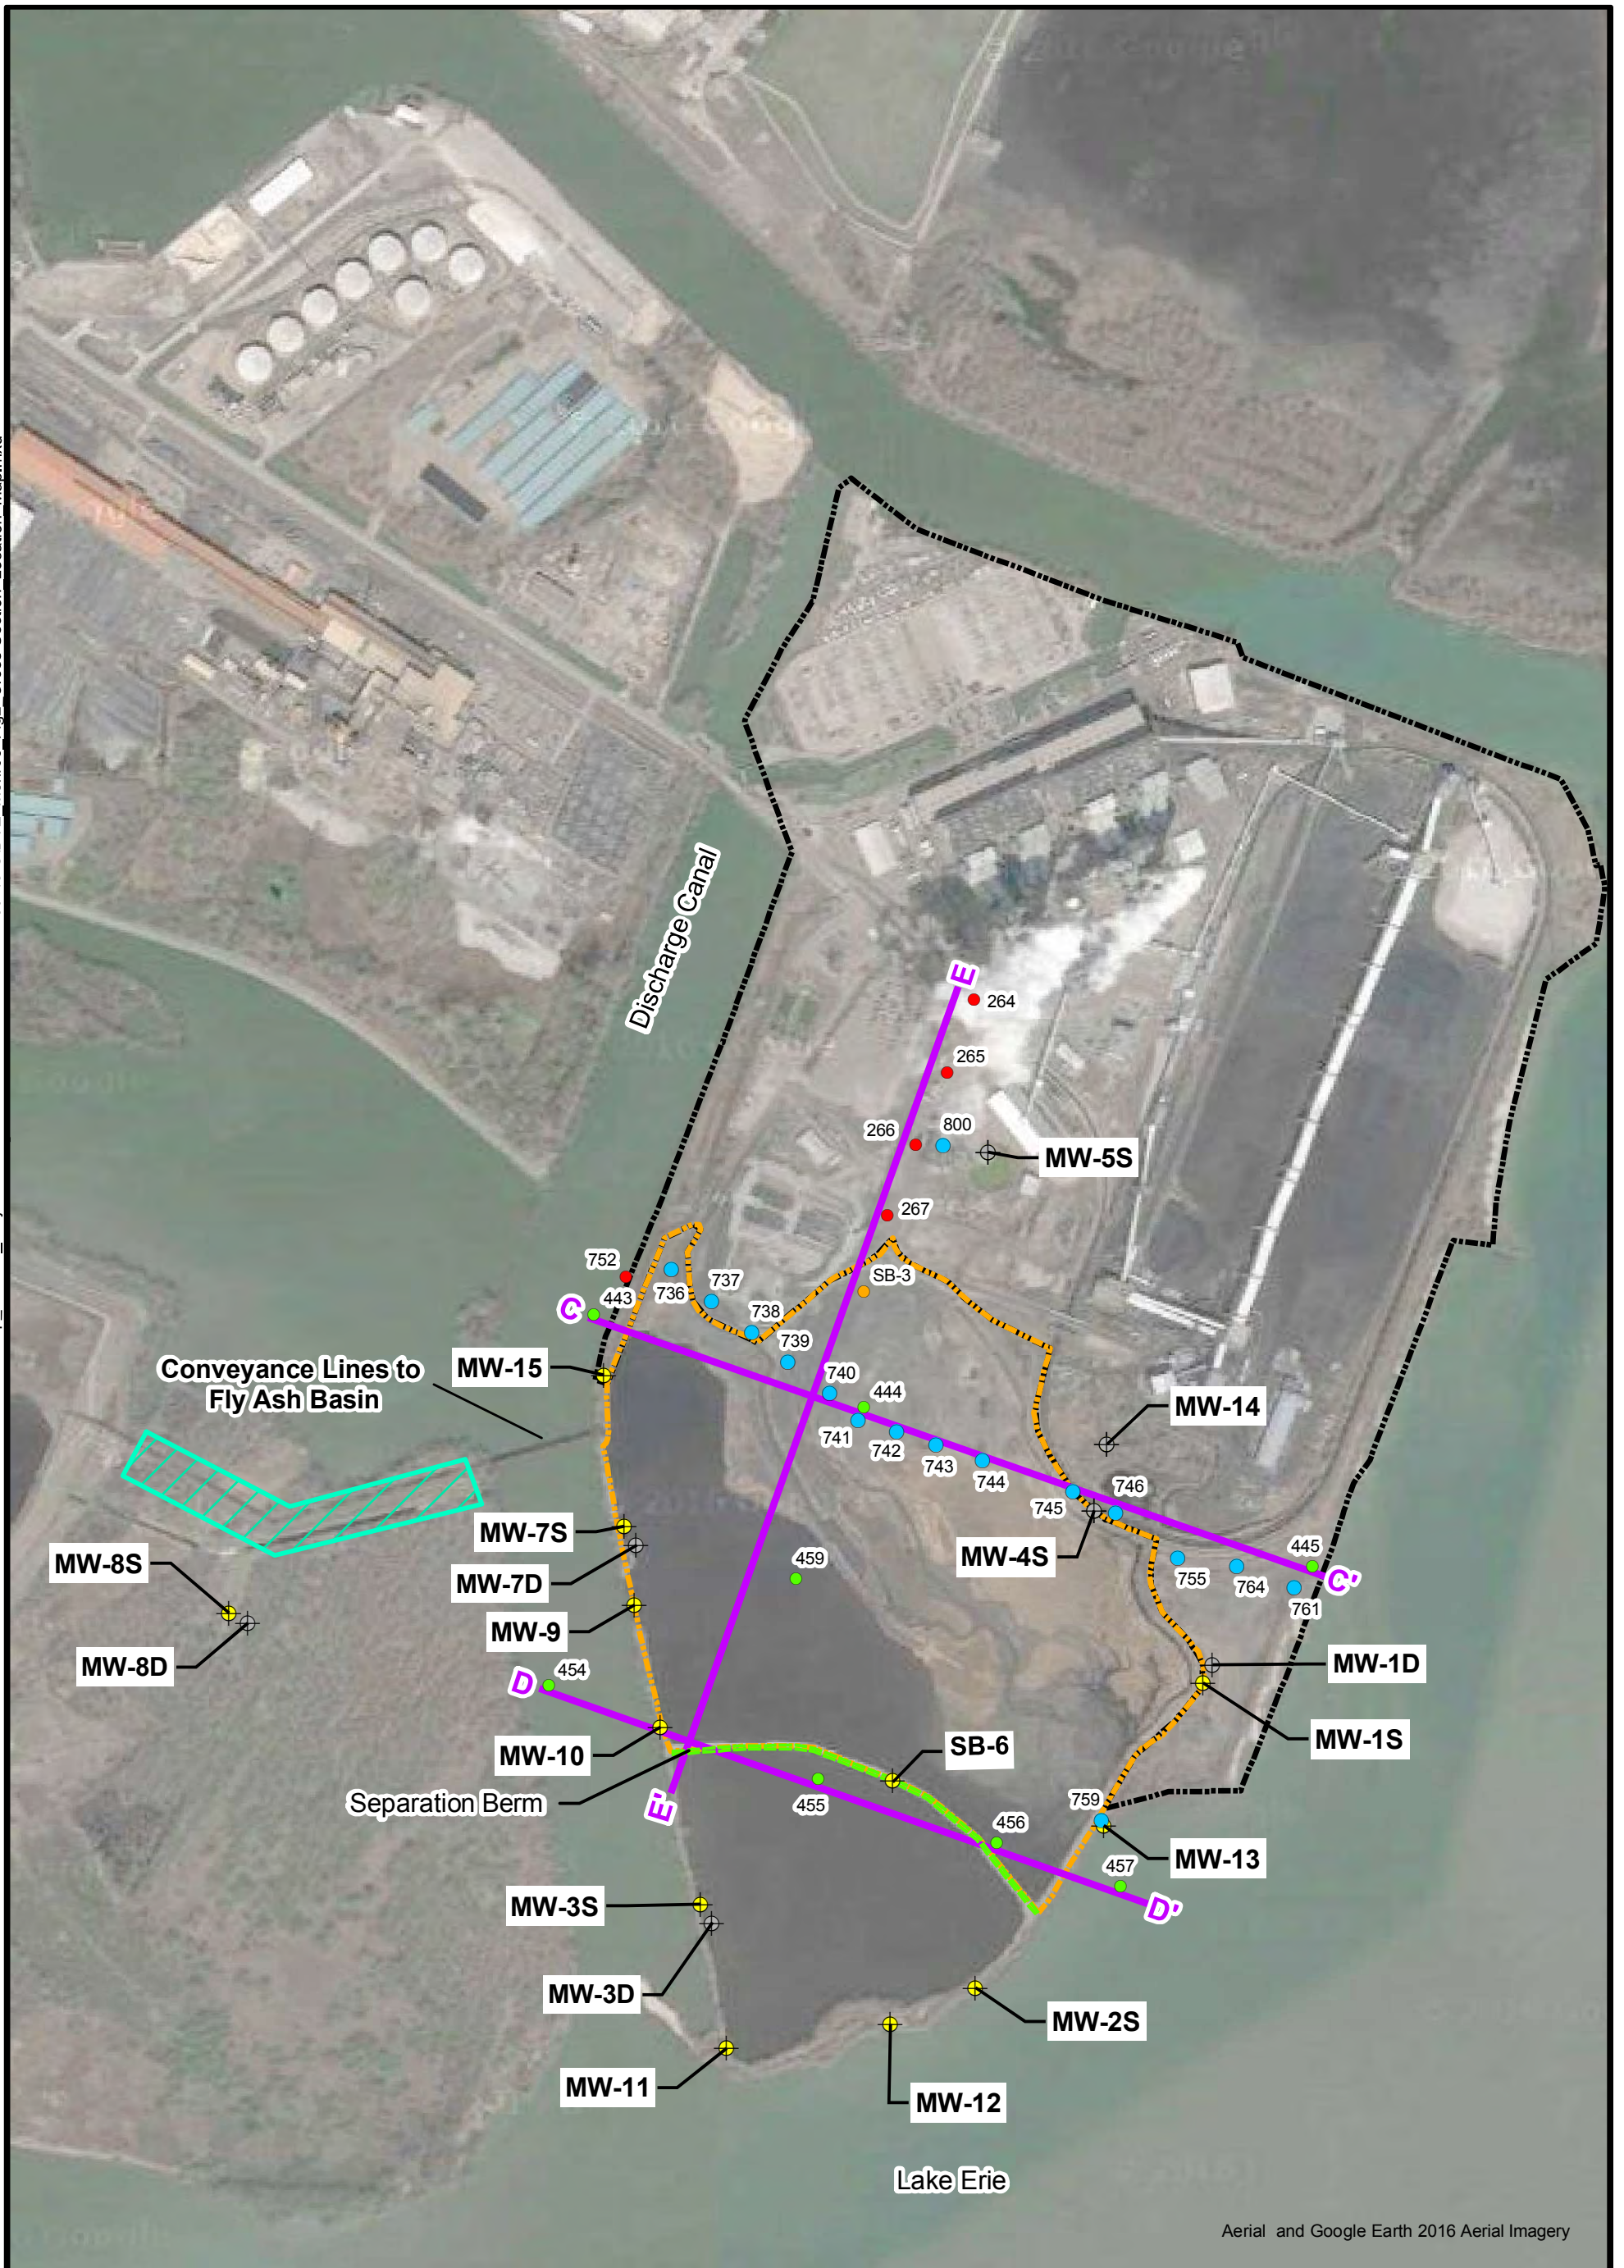


Aerial and Google Earth 2016 Aerial Imagery

LEGEND: CCR Program Monitoring Well Investigation Monitoring Well (Potentiometry Only) Soil Borings (NTH) Soil Boring pre-1971 Soil Boring 1971 and later Soil Boring 1971 and later with ash fill Soil Boring in 2015 by NTH with ash fill		Unit Separation Berm Cross Section Location Conveyance Line Boring Corridor (No Basal Sand)	Approximate Plant Boundary Approximate Boundary of Inactive Bottom Ash Basin
		Monroe Power Plant	
FIGURE 2 GEOLOGIC CROSS-SECTION LOCATION MAP			
DATE: 3/21/2019		SCALE 1 inch = 700 feet	
JOB NO. 60516675			

NORTHWEST

SOUTHEAST

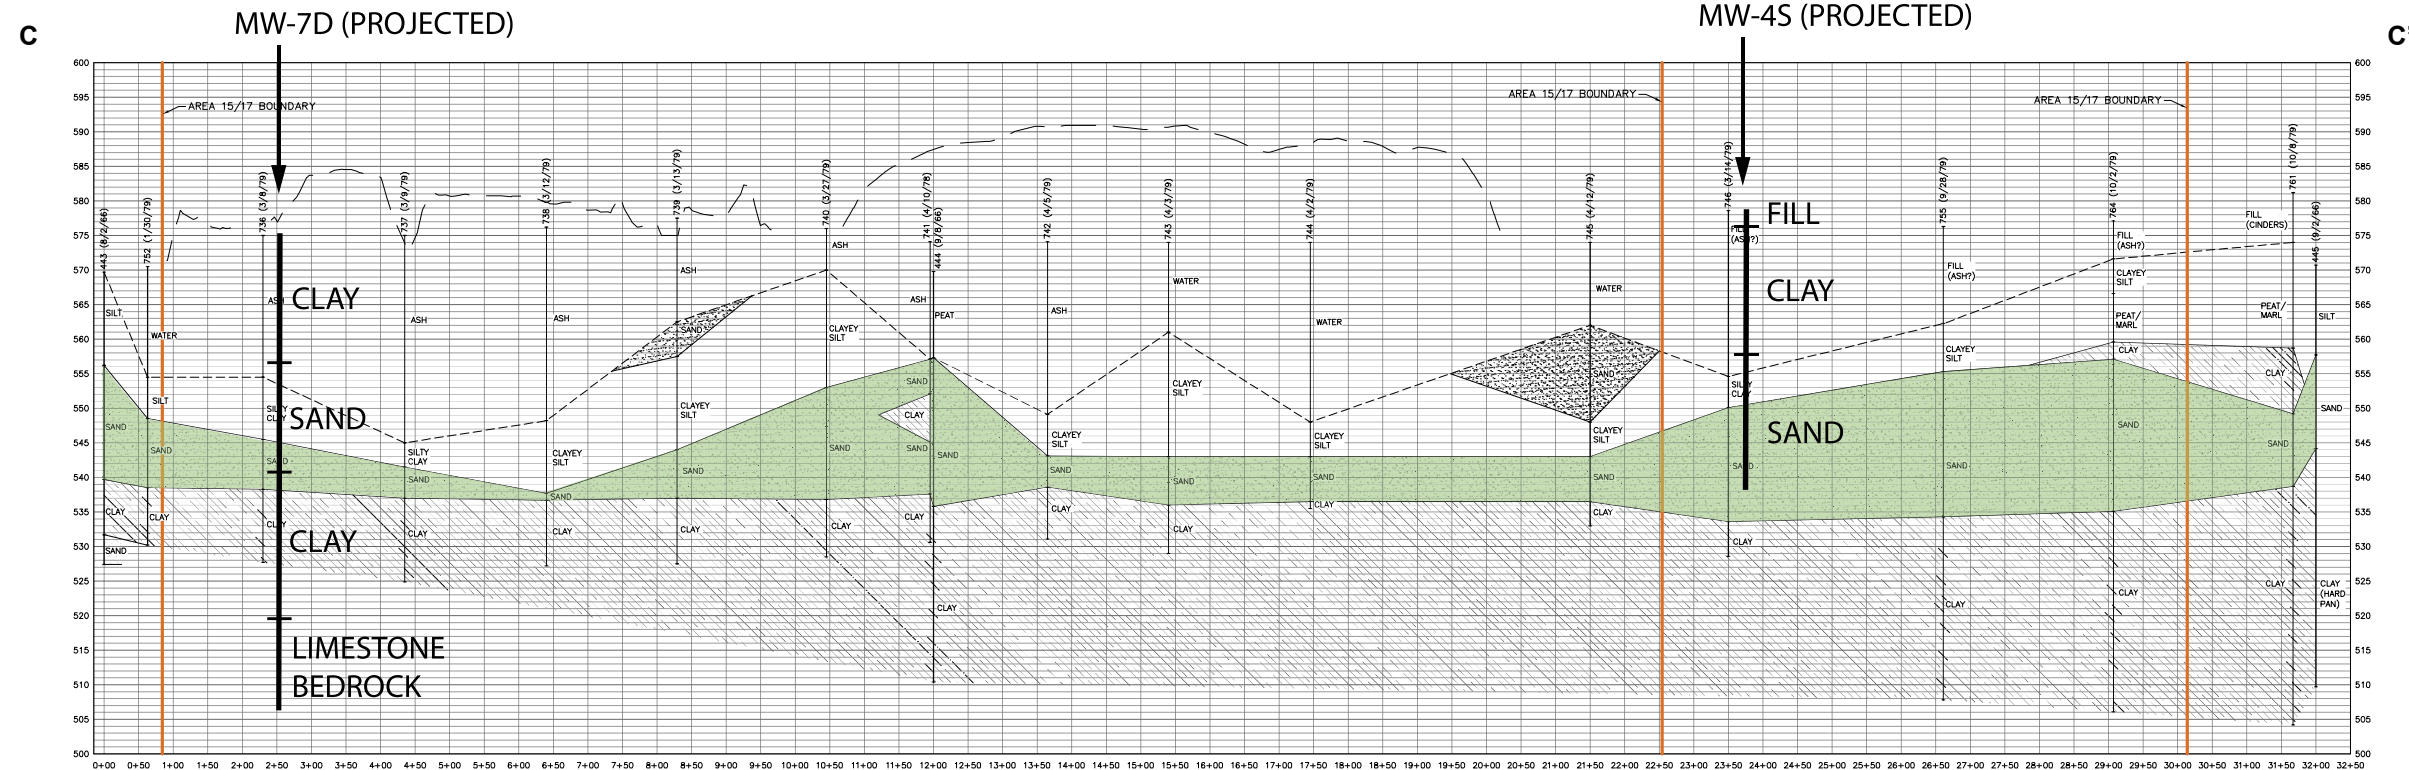

2
LATEST REVISION "0"
PMP NUMBER: 11107
GL/WBS2 NUMBER: I-000022-0211
PO NUMBER: 4700855696

NO.	DATE	ISSUED FOR	PROJ. ENG.	RESP. ENG.
PROJECT ENGINEER: PRECONSTRUCTION REVISION BLOCK - REV.				
APPROVALS				

Vendor:
NTH Consultants, Ltd.
Infrastructure Engineering & Environmental Services
Monroe, Michigan
NTH PROJECT NO. 62-150238-00
The Detroit Edison Co. Engineering

TITLE
AREA 15-17 CLOSURE
CROSS SECTIONS A,B,C
LOCATION NAME: MONROE POWER PLANT
ORIGINATING SOURCE: NTH CONSULTANTS, LTD.
DRAWING NUMBER: 2

THIS IS A CAD PRODUCED DRAWING.
ANY CHANGES OR REVISIONS TO
THIS DRAWING MUST BE COMPLETED
USING THE CAD SYSTEM.

LEGEND

	ASH		UPPERMOST AQUIFER
	CLAY		
	SAND		

PRELIMINARY
NOT FOR CONSTRUCTION

C				B				A				DETROIT EDISON APPROVALS		OTHER DISCIPLINE APPROVALS		DESIGNED BY	
PROJ. ENG.	PROJ. MGR.	DATE	DATE	PROJ. ENG.	PROJ. MGR.	DATE	DATE	PROJ. ENG.	PROJ. MGR.	DATE	DATE	DATE	DATE	DATE	DATE	DATE	DATE




DTE Energy Monroe Power Plant

FIGURE 2a
NTH CONSULTANTS, LTD - GEOLOGIC
CROSS-SECTION C - C'


DATE	REV. NO.	DWG. BY	CHKD. BY
03/20/19	1	JMA	WBL

JOB NO. 60516675 **AECOM**

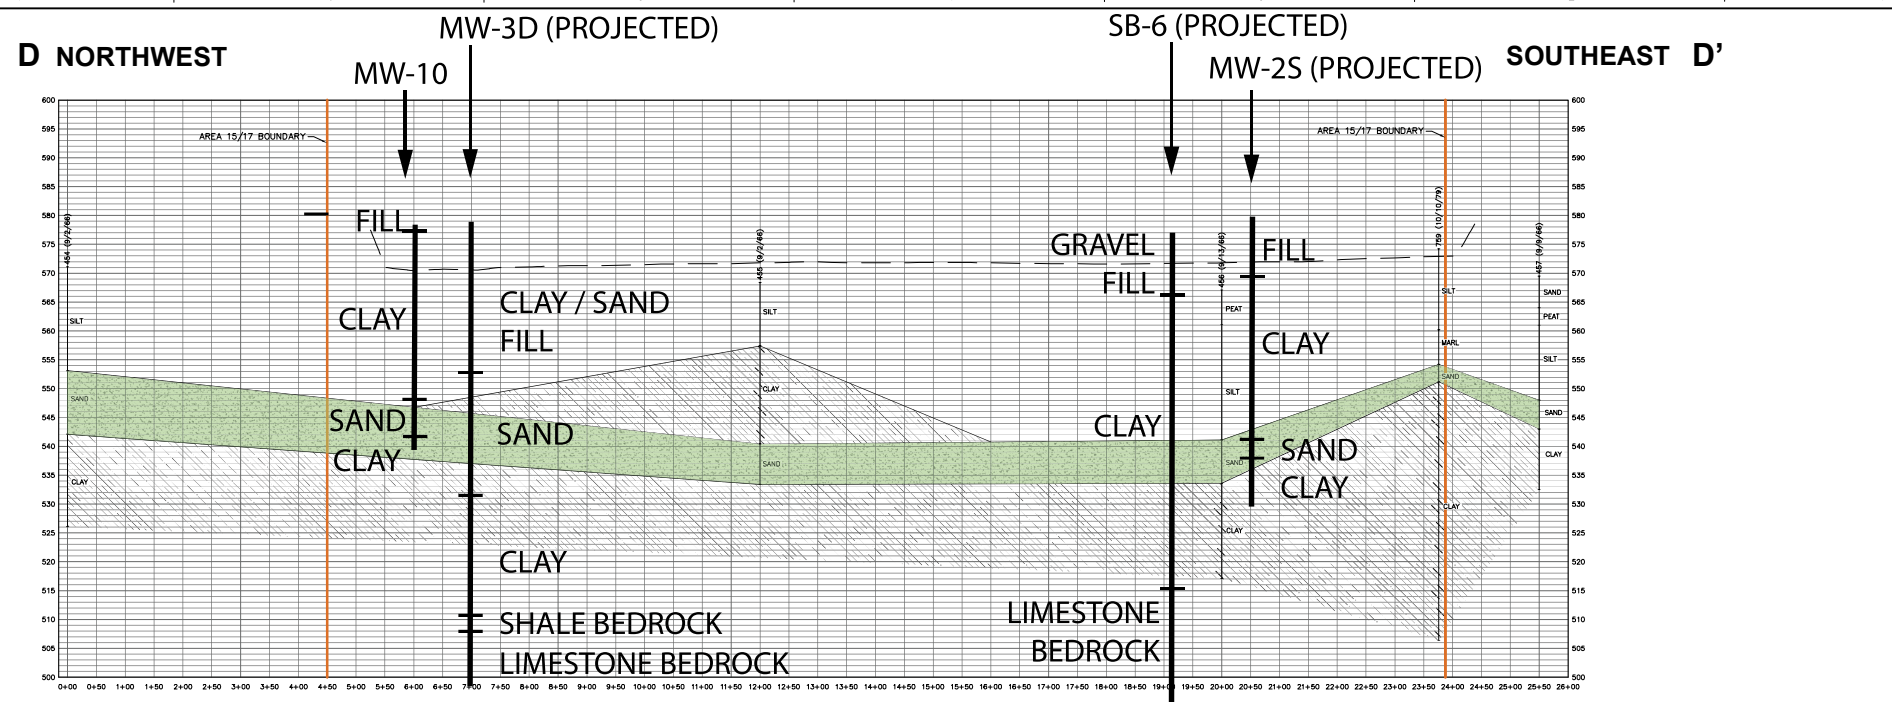

NORTHEAST E

E' SOUTHWEST

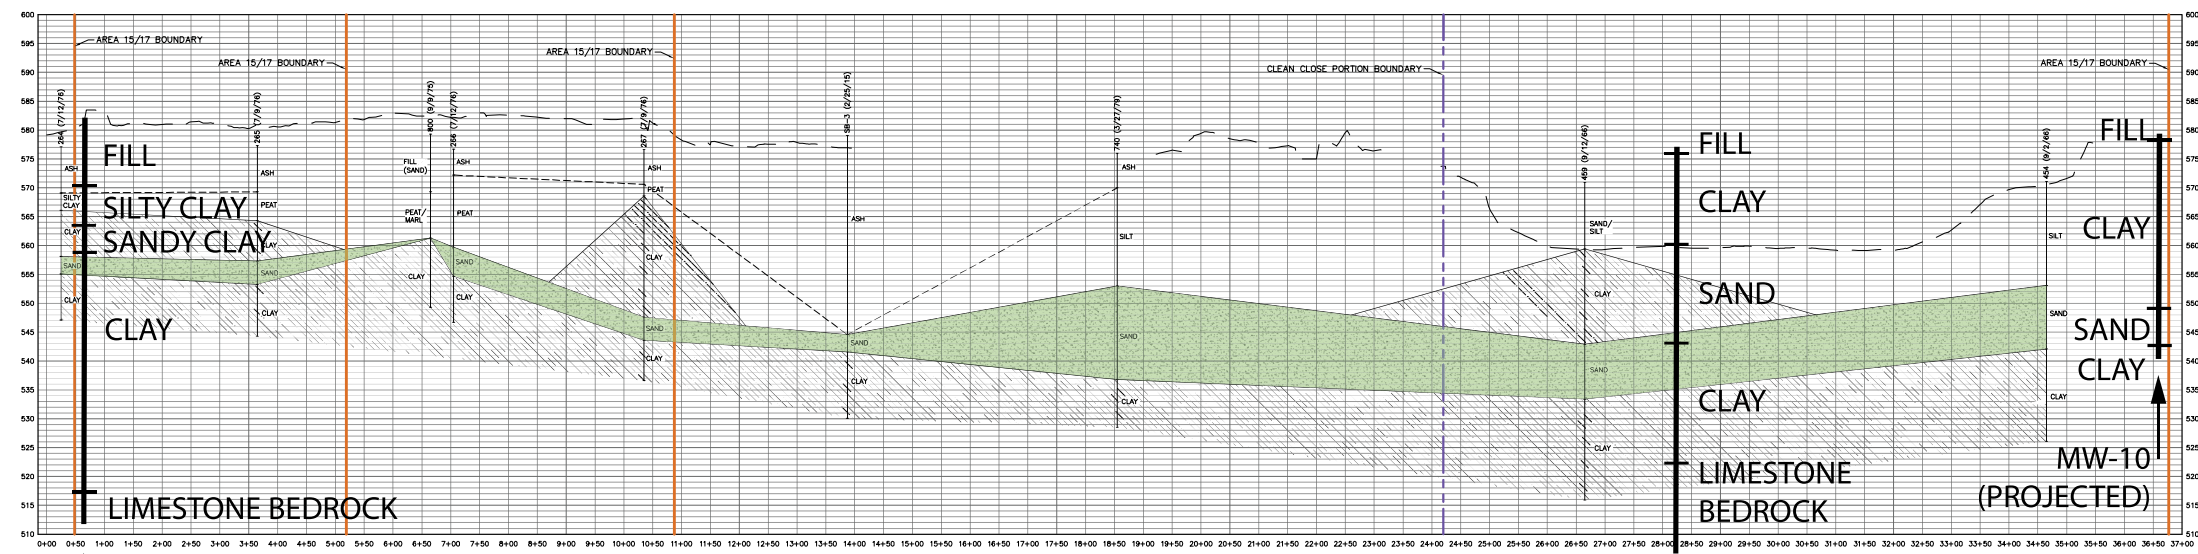

LEGEND
 ASH
 CLAY
 SAND
 UPPERMOST AQUIFER

PRELIMINARY
 NOT FOR CONSTRUCTION

C				B				A			
PROJ.	DESIGN	DATE	BY	PROJ.	DESIGN	DATE	BY	PROJ.	DESIGN	DATE	BY

3
 LATEST REVISION "O"
 PMP NUMBER: 11107
 GL/WBS2 NUMBER: 1-000022-0211
 PG. NUMBER: 475085696

NO.	DATE	ISSUED FOR	PROJ. ENG.	RESP. ENG.

Vendor:
 NTH Consultants, Ltd.
 NTH PROJECT NO. 60-150259-00
The Detroit Edison Co. **Engineering**

AREA 15-17 CLOSURE
 CROSS SECTIONS D,E
 LOCATION NAME: MONROE POWER PLANT
 UNIT NUMBER: 1-4
 SCALE: AS SHOWN
 DRAWING NUMBER: 3



DTE Energy *Monroe Power Plant*

FIGURE 2b
NTH CONSULTANTS, LTD
GEOLOGIC CROSS-SECTIONS D - D' AND E - E'

DATE	REV. NO.	DWG. BY	CHKD. BY
03/20/19	1	JMA	WBL

JOB NO. 60489524 **AECOM**

Appendix C




National Wetland Inventory Map


Wetlands Map Viewer



March 9, 2020

Part 303 Final Wetlands Inventory

-  Wetlands as identified on NWI and MIRIS maps
-  Soil areas which include wetland soils
-  Wetlands as identified on NWI and MIRIS maps and soil areas which include wetland soils
-  Gage Stations
-  National Wetlands Inventory 2005

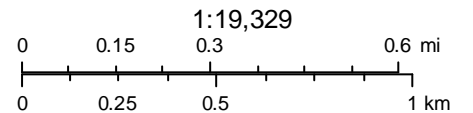


Sources: Esri, HERE, Garmin, USGS, Intermap, INCREMENT P, NRCan, Esri Japan, METI, Esri China (Hong Kong), Esri Korea, Esri (Thailand), NGCC, (c) OpenStreetMap contributors, and the GIS User Community
Source: Esri, DigitalGlobe, GeoEye, Earthstar Geographics, CNES/Airbus DS,

Appendix D

U.S. Quaternary Faults and Folds Map

US Quaternary Faults and Folds

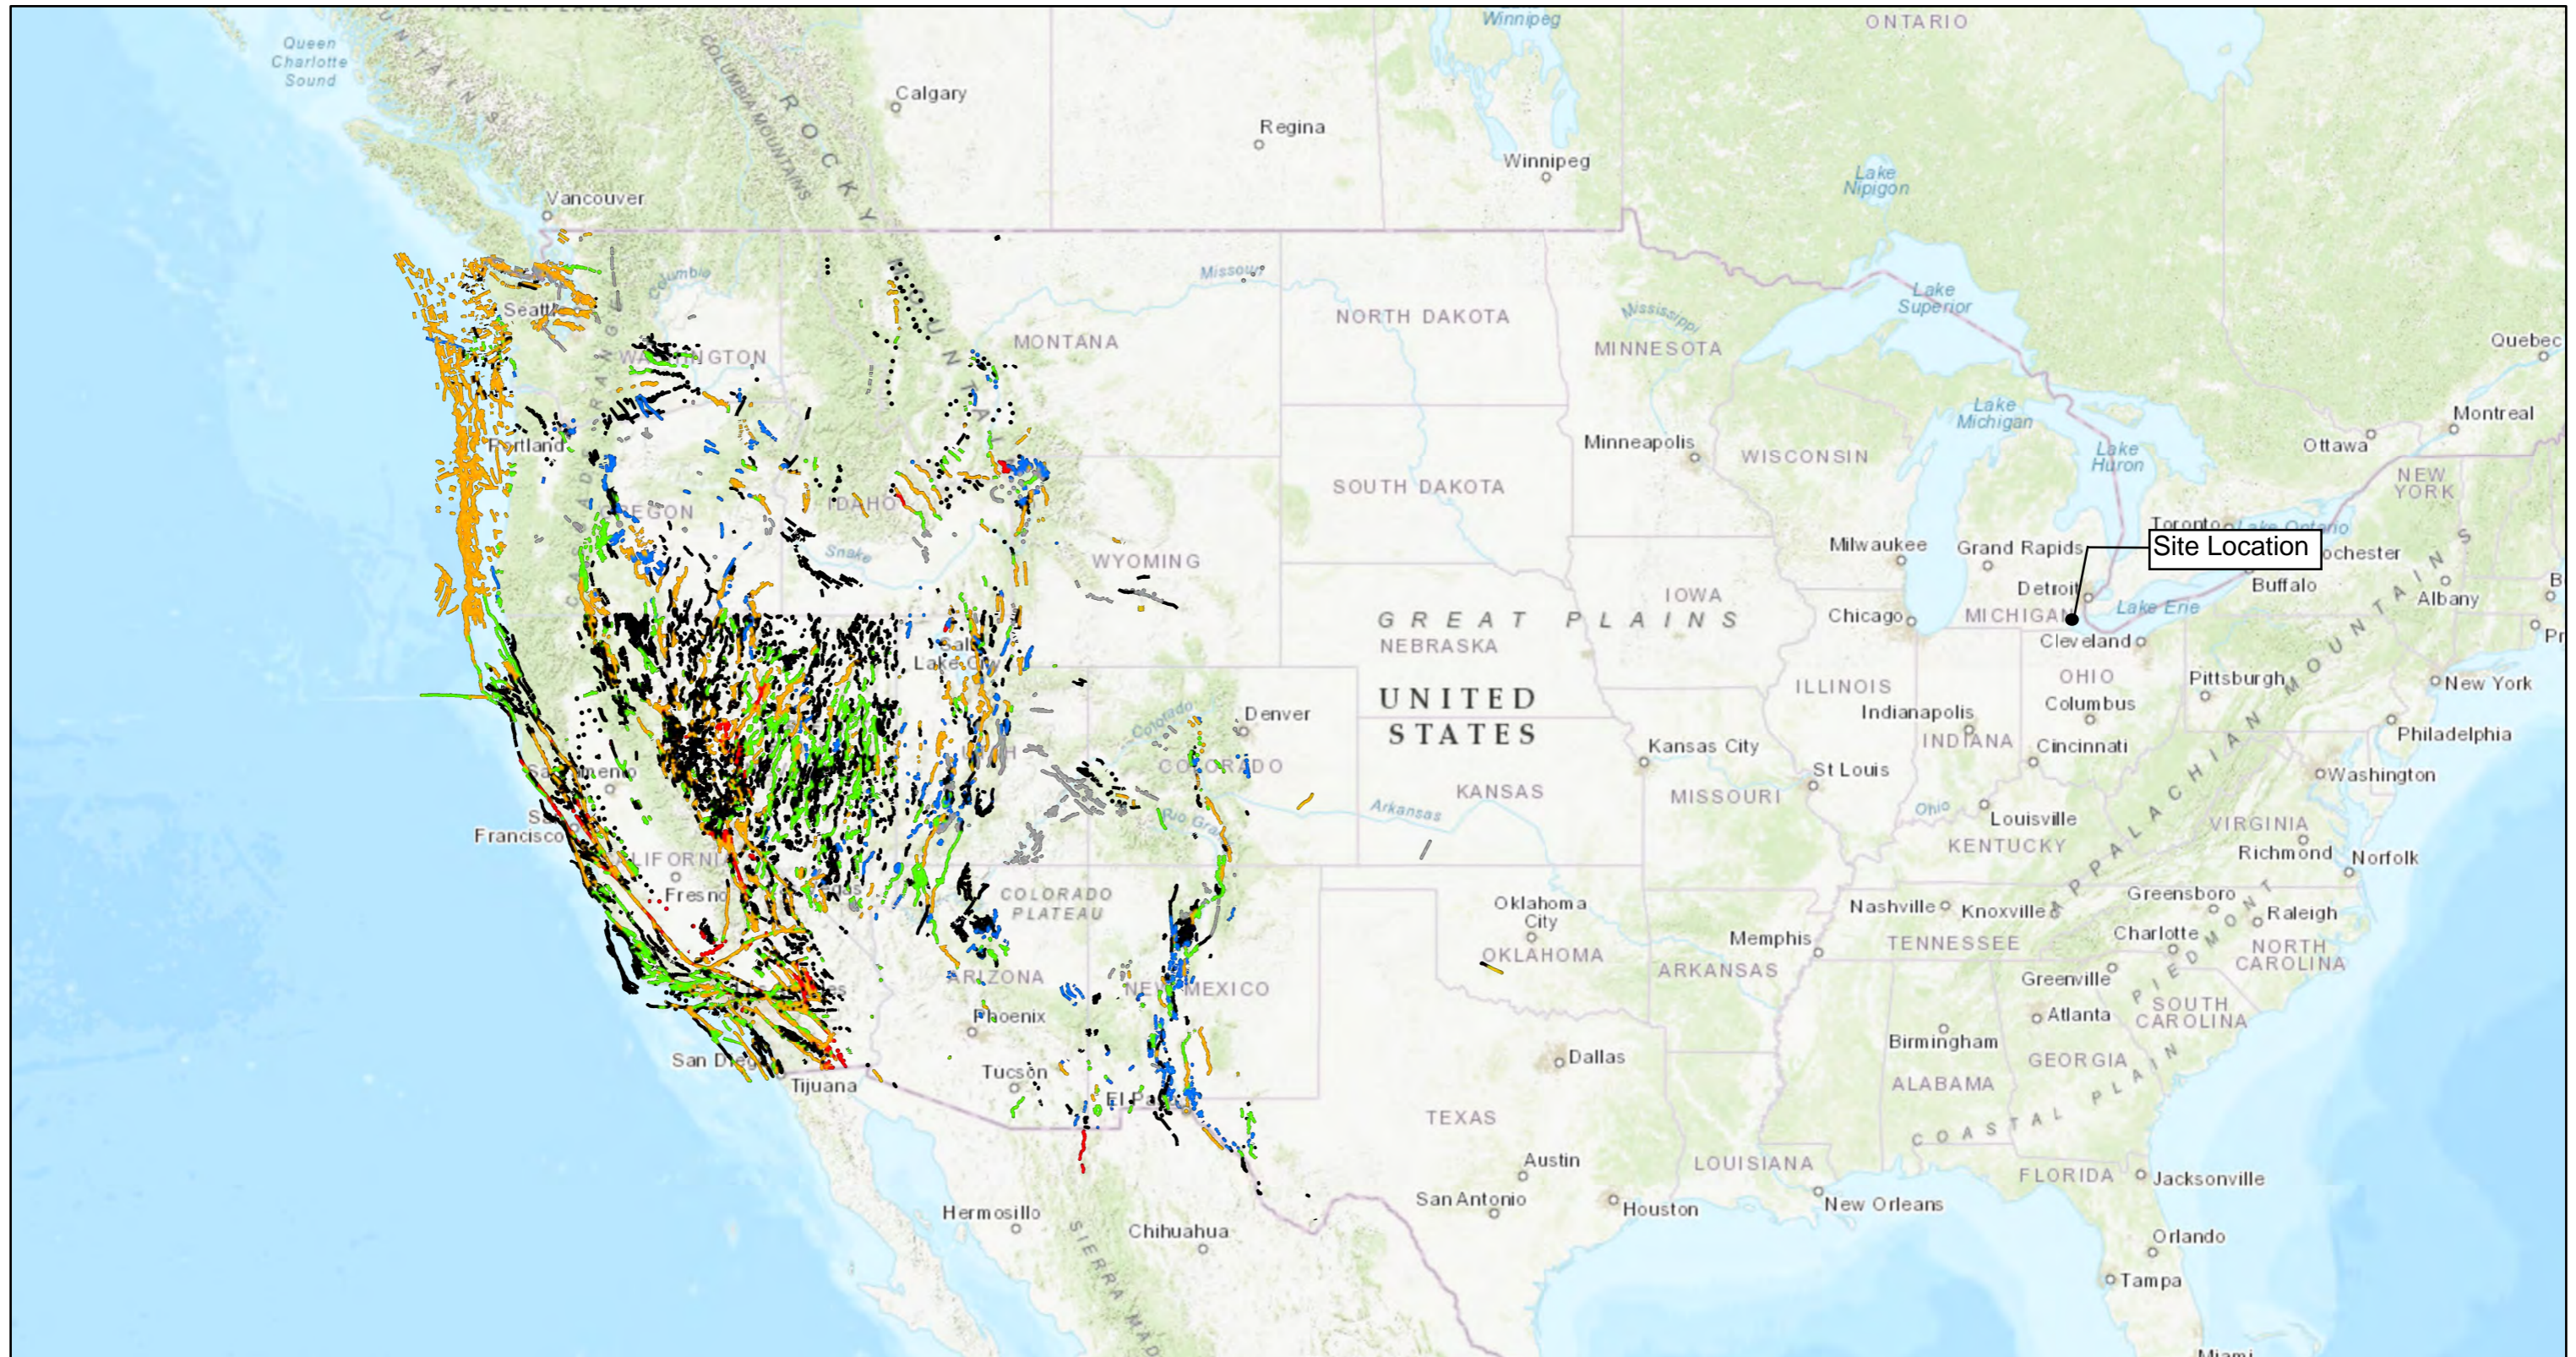


9/7/2018 3:20:39 PM

1:18,489,298

Quaternary faults

- unspecified age, well constrained location
- - - unspecified age, moderately constrained location
- .. unspecified age, inferred location
- undifferentiated Quaternary (< 130,000 years), well constrained location
- - - undifferentiated Quaternary (< 130,000 years), moderately constrained location

- .. undifferentiated Quaternary (< 130,000 years), inferred location
- middle and late Quaternary (< 1.6 million years), well constrained location
- - - middle and late Quaternary (< 1.6 million years), moderately constrained location
- .. middle and late Quaternary (< 1.6 million years), inferred location
- latest Quaternary (< 15,000 years), well constrained location
- - - latest Quaternary (< 15,000 years), moderately constrained location
- .. latest Quaternary (< 15,000 years), inferred location
- late Quaternary (< 130,000 years), well constrained location

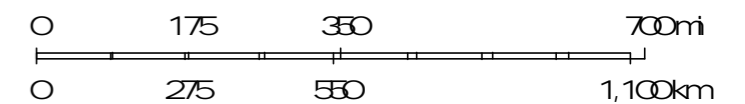

Sources: Esri, HERE, Garmin, Intermap, increment P Corp., GEBCO, USGS, FAO, NPS, NRCAN, GeoBase, IGN, Kadaster NL, Ordnance Survey, Esri Japan, METI, Esri China (Hong Kong), swisstopo, © OpenStreetMap contributors, and the GIS User Community, USGS

Appendix E

Seismic Design Curves

Unified Hazard Tool






Please do not use this tool to obtain ground motion parameter values for the design code reference documents covered by the [U.S. Seismic Design Maps web tools](#) (e.g., the International Building Code and the ASCE 7 or 41 Standard). The values returned by the two applications are not identical.

^ Input

Edition Dynamic: Conterminous U.S. 2014 (upda	Spectral Period Peak Ground Acceleration
Latitude Decimal degrees 41.872	Time Horizon Return period in years 2475
Longitude Decimal degrees, negative values for western longitudes -83.345	
Site Class 760 m/s (B/C boundary)	

^ Hazard Curve

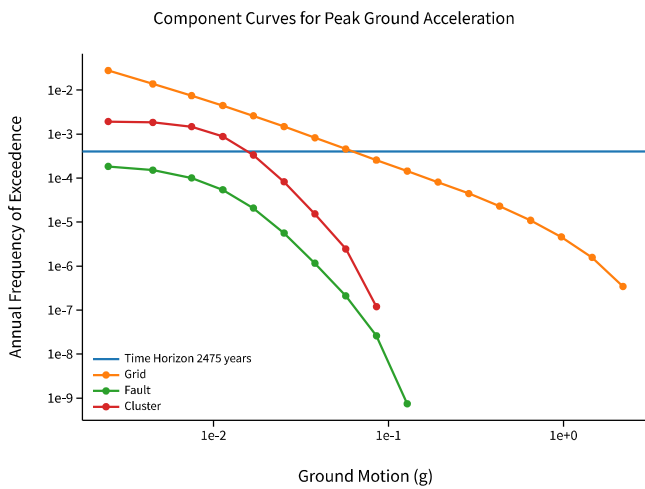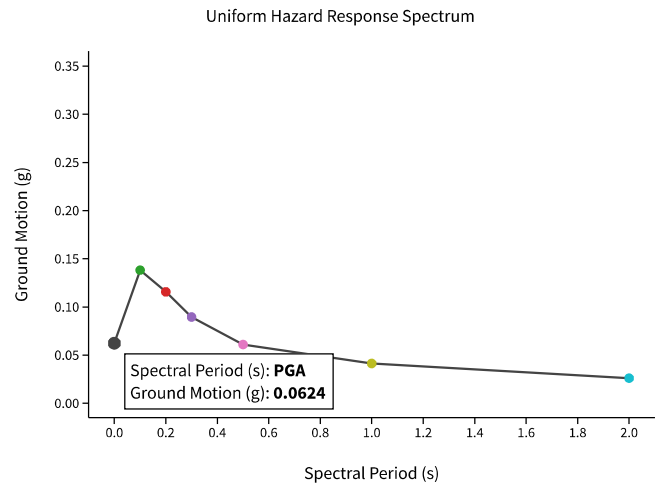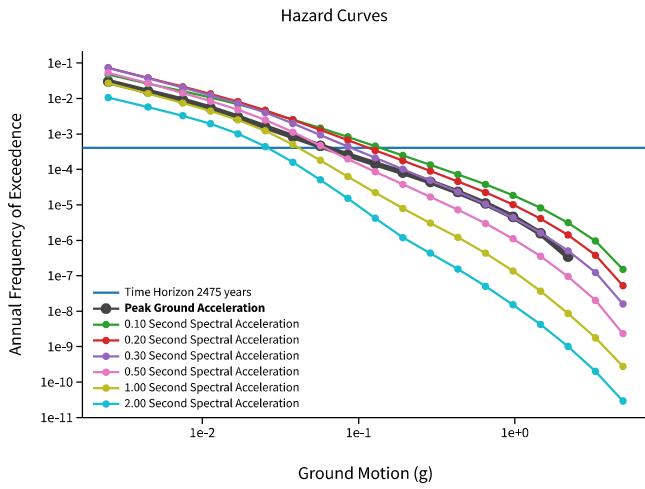

[View Raw Data](#)